

RECORD OF SURVEY

No. 84


Township 4 South Range 41 East W.M., Union County, Oregon.

Elradore Grapes

July the 7 1889

CHAINS.

LKS.

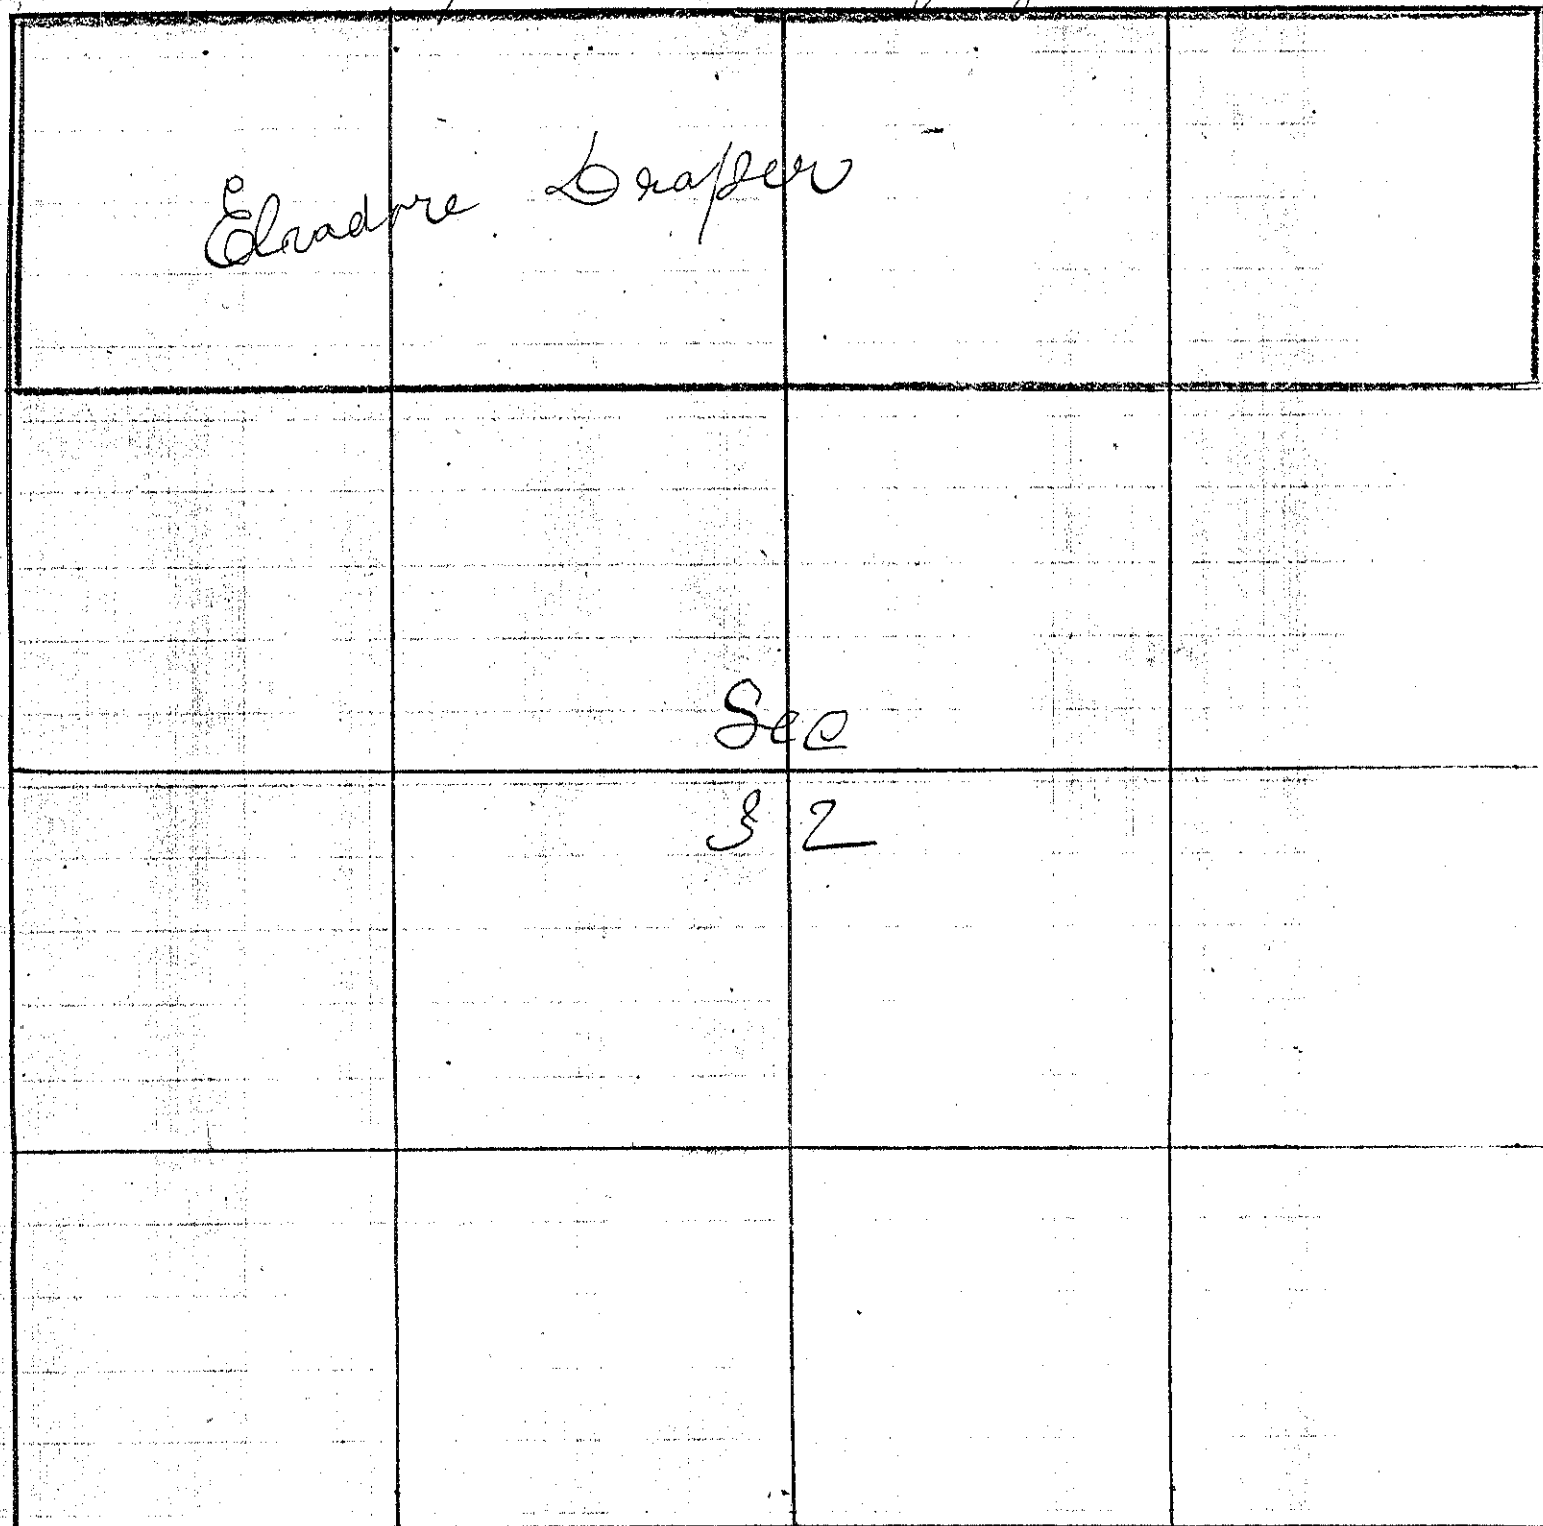

I Commenced at the 1/4 Sec corner between Sec 29 & 32 which is a stone marked 1/4 S.

Hence East to Sec 29 & 32

Var 20° E

35 25 Intersect 100 lks South of the corner to Sec 28 = 29 = 32 655

Hence S 88° 34' W on true line

35 25 the 1/4 Sec. corner to Sec 29 & 32

J.W. Kimbrell County Surveyor