


Township 6 South

Range 38 East W.M.

Union County, Oregon.

CHAINS LKS.

C. M. Kellogg & Co. July the 11 1889

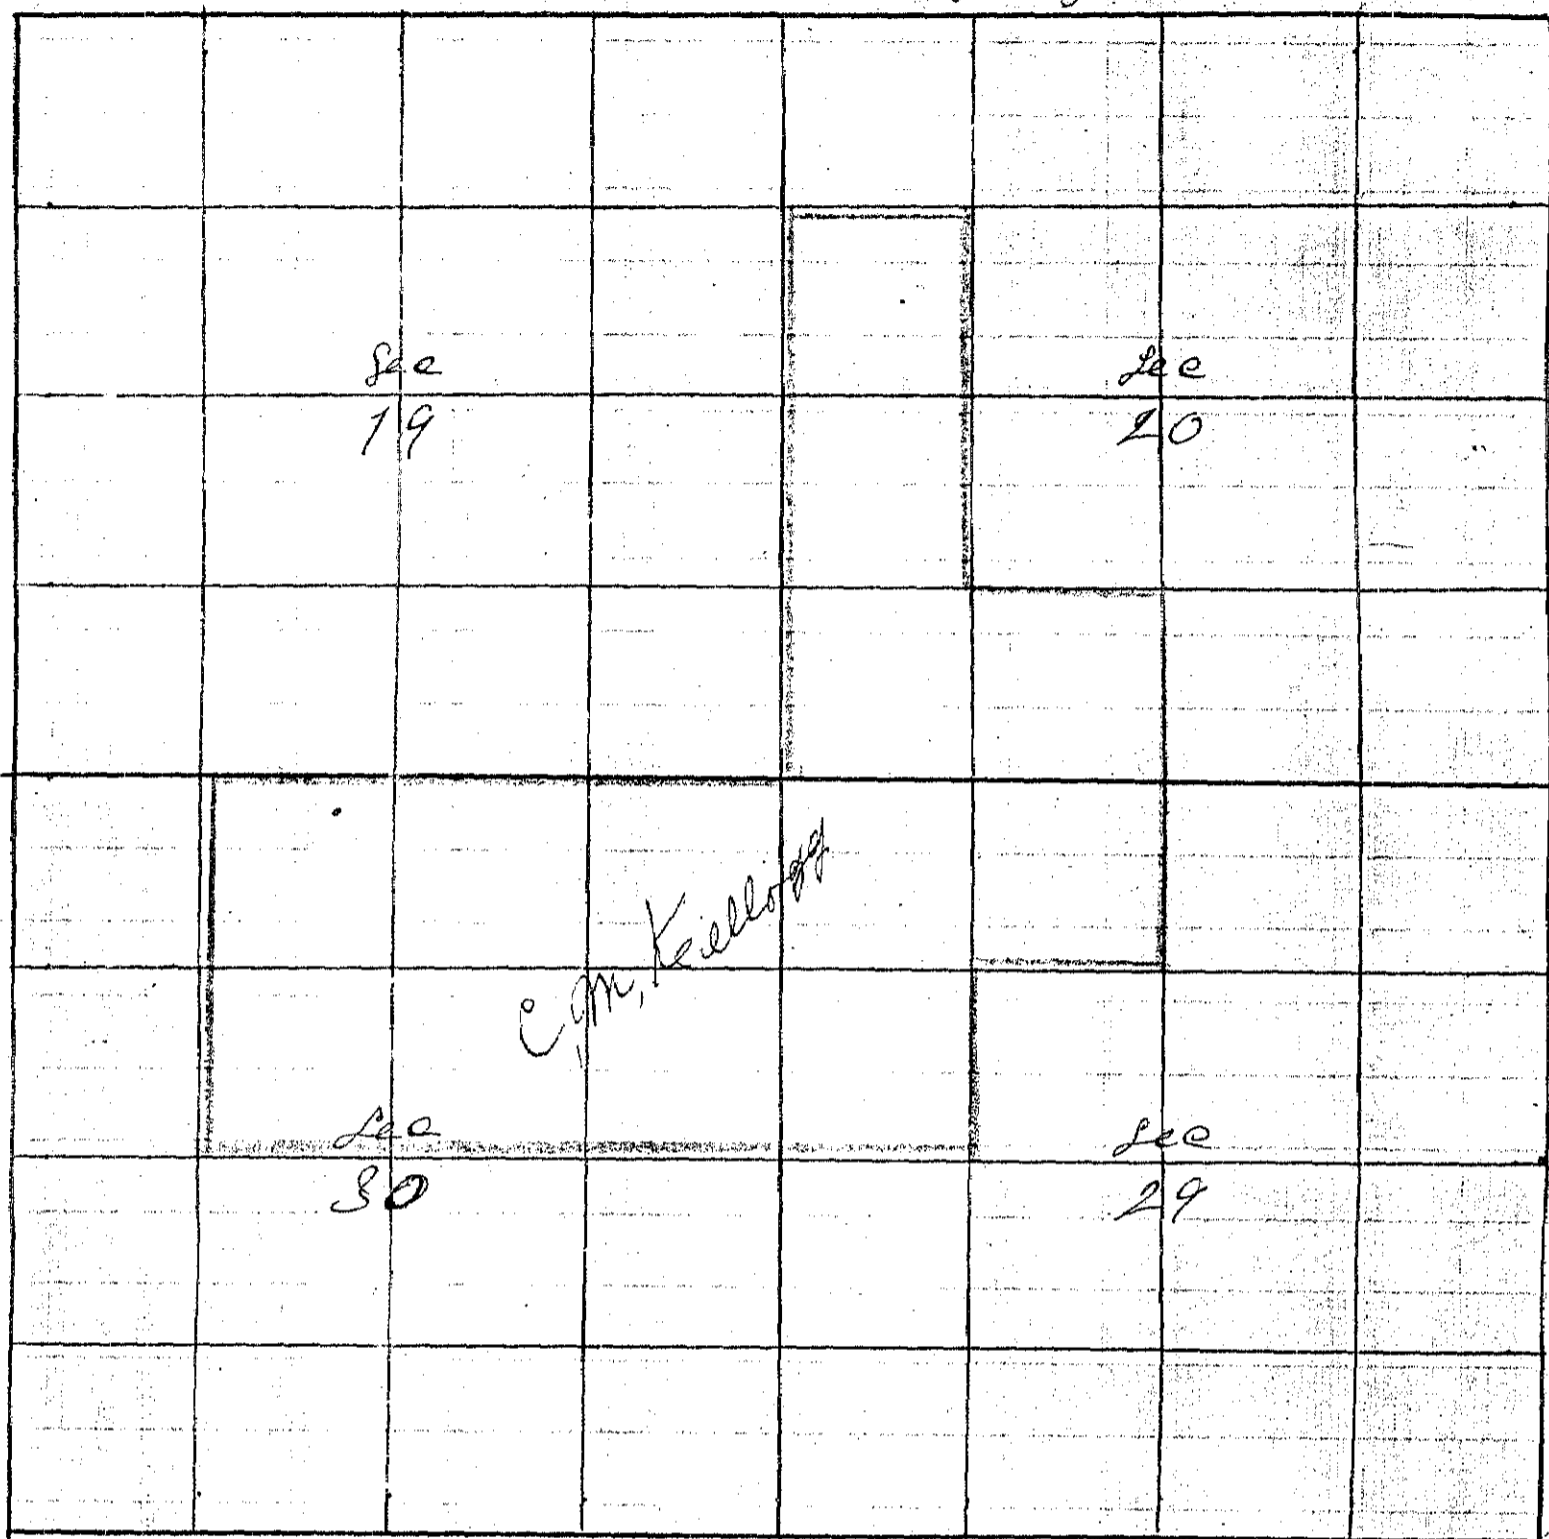

Commenced at the 14 sec corner bet sec 10 & 29
Thence N 86° 21' E

19 85 the 1/2 corner previously set by me for Thos Turner

39 70 the corner of sec 20 = 21 = 28 & 29

from which

a cottonwood 16 in dia. brs N 65° W 12 lbs dist.

" 24 " " " N 65° E 8 " "

" 10 " " " S 50° E 18 " "

an alder 6 " " " S 30° W 25 " "

Thence South bet sec 28 & 29

over 20° E

40 00 found no 14 sec corner set temporary 1/4 sec corner

80 50 found no sec corner U.S. Field Notes Thompson & Chapin 1864

84 92 found no sec corner U.S. Field Notes W.B. Barr 1881

95 00 the corner to sec 28 = 29 = 32 & 33

a Pine 10 in brs N 30° E 88 lbs dist.

" 36 " " S 77° E 79 " "

" 20 " " S 55° W 89 " "

" 10 " " N 45° W 145 " "

CHAINS.	LKS.	
		Hence North bet Sec 28 & 29
47	00	Creek 25 lks wide course East
45	00	Set Post for 1/4 Sec corner bet Sec 28 & 29
90	00	The corner to Sec 20 = 21 = 28 & 29

Note

Thompson and Chaplain in 1884 in Establishing the line bet Sec 28 & 29 Reports it to be 8000 Chains and W. B. Barr in Surveying the Remainder of this Township in 1881 makes the following Note

East on Random line bet Sec 20 & 29
Var 21° 10' E

40	00	Set Temporary 1/4 Sec corner
79	70	Intersect N & S line 510 lks South of corner to Sec 20 = 21 = 28 & 29

I Carefully Measure the distance between the Established corners to Sec 28 = 29 = 32 & 33 and Sec 20 = 21 = 28 & 29 and found it to be 8492 Chains I therefore run S 86° 21' W on True line bet Sec 20 & 29.

The 1/4 Sec corner bet Sec 28 & 29
Hence S 88° W through Sec 29
Var 20° E

20	00	Set Temporary 1/16 corner
79	50	Intersect 146 lks South of 1/4 Sec corner bet Sec 29 & 30 from which

a Pine 12 inches dia. bet S 4 1/2° W 83 lks dist
" 20 " " " S 33 1/2° E 107 " "

Hence N 89° 3' E on True line

19	88	Set Post for 1/16 corner in center W 1/2 Sec 29
39	75	The center Sec 29
59	62 1/2	The center E 1/2 Sec 29
79	50	The 1/4 Sec corner bet Sec 28 & 29

The corner to Sec 19 = 20 = 29 & 30

from which
a Pine 12 inches dia bet N 58° 8' 72 lks dist
" 10 " " " N 57° W 20 " "
a Pine 20 " " " S 10° E 108 " "
" 21 " " " S 25° W 109 " "

Township 6 South Range 38 East Union County, Oregon.

Hence west bet Sec 19 & 30
 var $20^{\circ} 8'$
 20 50 Set Temporary $\frac{1}{8}$ corner
 40 52 Intersect 152 lks North of $\frac{1}{4}$ Sec corner bet Sec 19 & 30
 from which
 a Pine 24 inches dia. bet $N 45^{\circ} E 25$ lks dist.
 " 9 " " " $S 53^{\circ} W 25$ " "
 Hence $N 87^{\circ} 49' E$ on true line
 20 26 Set Post for $\frac{1}{8}$ corner

 The $\frac{1}{4}$ Sec corner bet Sec 19 & 30
 Hence west bet Sec 19 & 30 var $20^{\circ} 8'$
 20 50 Set Temporary $\frac{1}{8}$ corner
 42 50 Intersect West Boundary 466 lks North of the
 corner to Sec 19 = 30 = 24 & 25 -
 Hence $N 80^{\circ} 47' E$ on true line
 21 25 Set Post for $\frac{1}{8}$ corner
 42 50 The $\frac{1}{4}$ Sec corner bet Sec 19 & 30

 The $\frac{1}{4}$ Sec corner bet Sec 30 & 25 - on Range line
 bet Ranges 37 & 38 East
 Hence East through Sec 30
 20 36 Set Post for center W $\frac{1}{4}$ Sec 30
 60 75 Set Post for center E $\frac{1}{2}$ Sec 30
 from which
 a Pine 8 in dia bet $N 85^{\circ} E 17$ lks dist.
 " 8 " " " $S 78^{\circ} W 14$ " "
 81 15 The $\frac{1}{4}$ Sec corner bet Sec 29 & 30

 The corner of Sec 19 = 20 = 29 & 30
 Hence North bet Sec 19 & 20
 var $21^{\circ} 6'$
 41 41 Intersect 112 lks East of $\frac{1}{4}$ Sec corner bet Sec 19 & 20
 Hence South 48' E on true line
 20 71 Set Post for $\frac{1}{8}$ corner

J. W. Kimbell County Surveyor