

Township 7 1/2 South


Range 42 East W.M.

Union County, Oregon.

Houghton Perry & Co

Aug. the 7 1889

CHAINS. LRS.

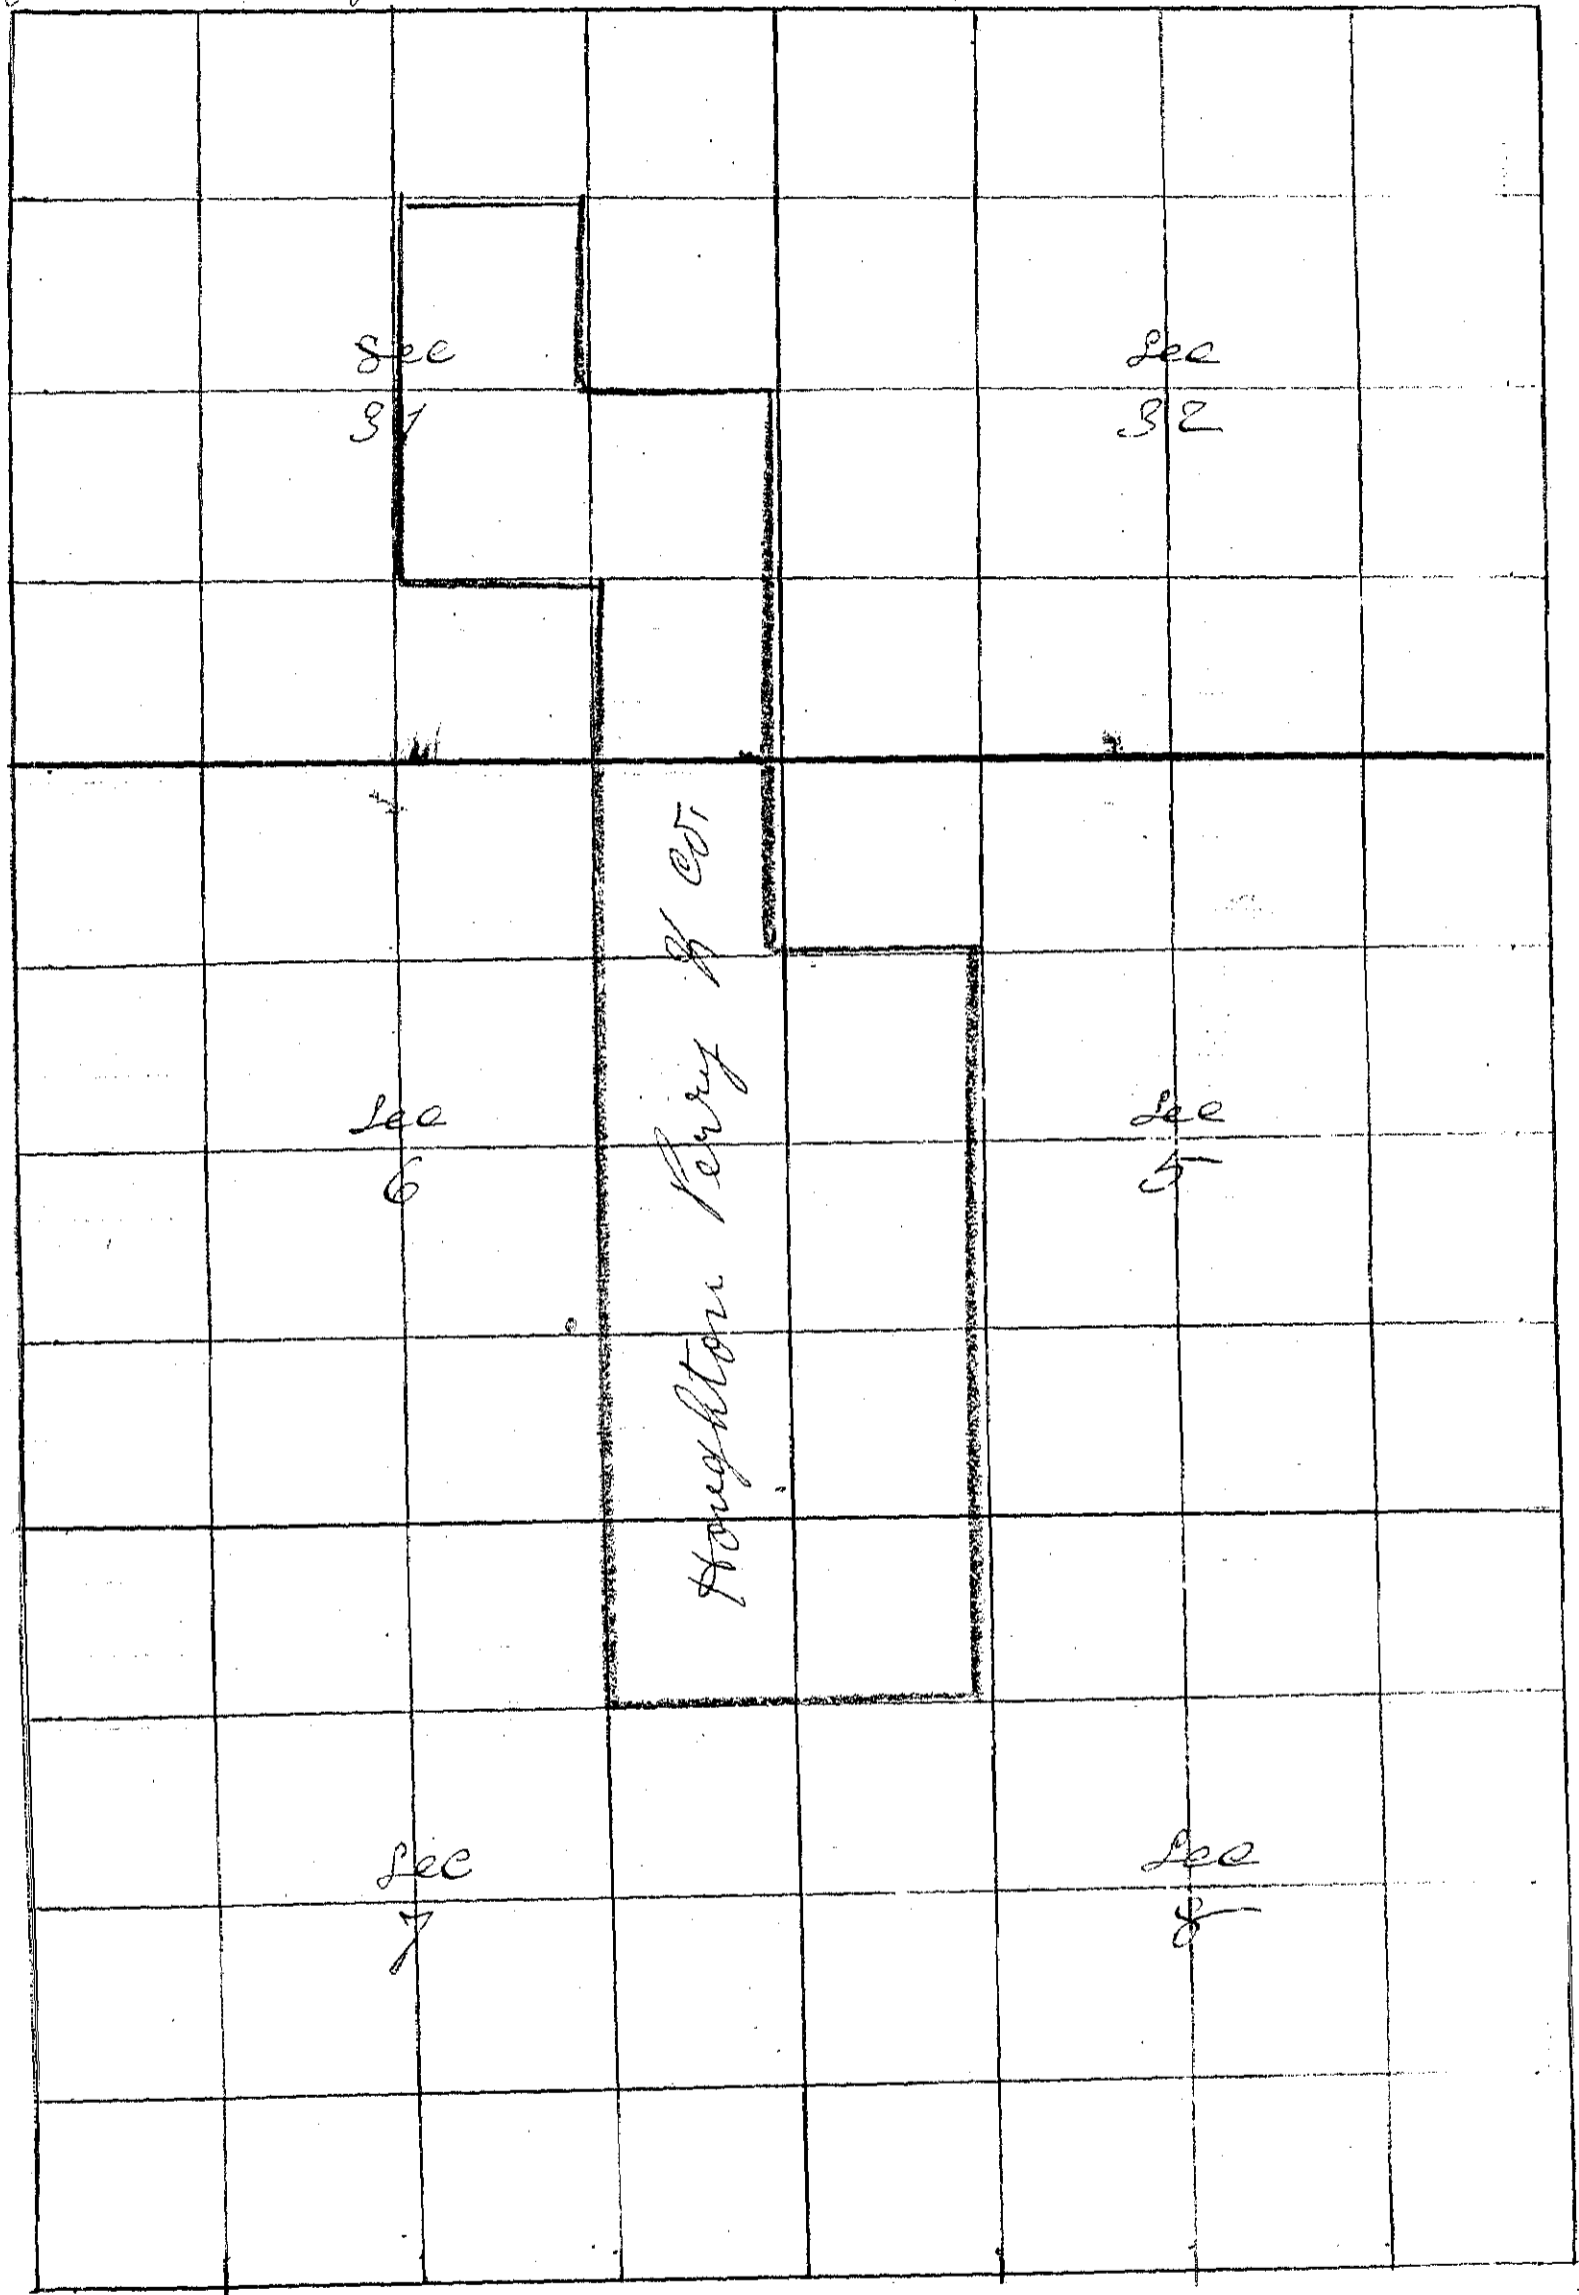

I Commenced at the 1/4 Sec corner bet Sec 6 & 7
 Hence East bet Sec 6 & 7
 (var 20° 0')

20 00 Set temporary 1/8 corner
 40 00 found no Sec corner Set temporary corner to be 5262
 Hence East bet Sec 5 & 8
 var 20° 0'

70 00 Returned - 40 to south of base corner bet Sec 6 & 7