


Township 7 South Range 39 East W.M. Union County, Oregon.

CHAINS. LKS. Jacob Hug John McGinis & J.W. Norval Oct. 19 1889

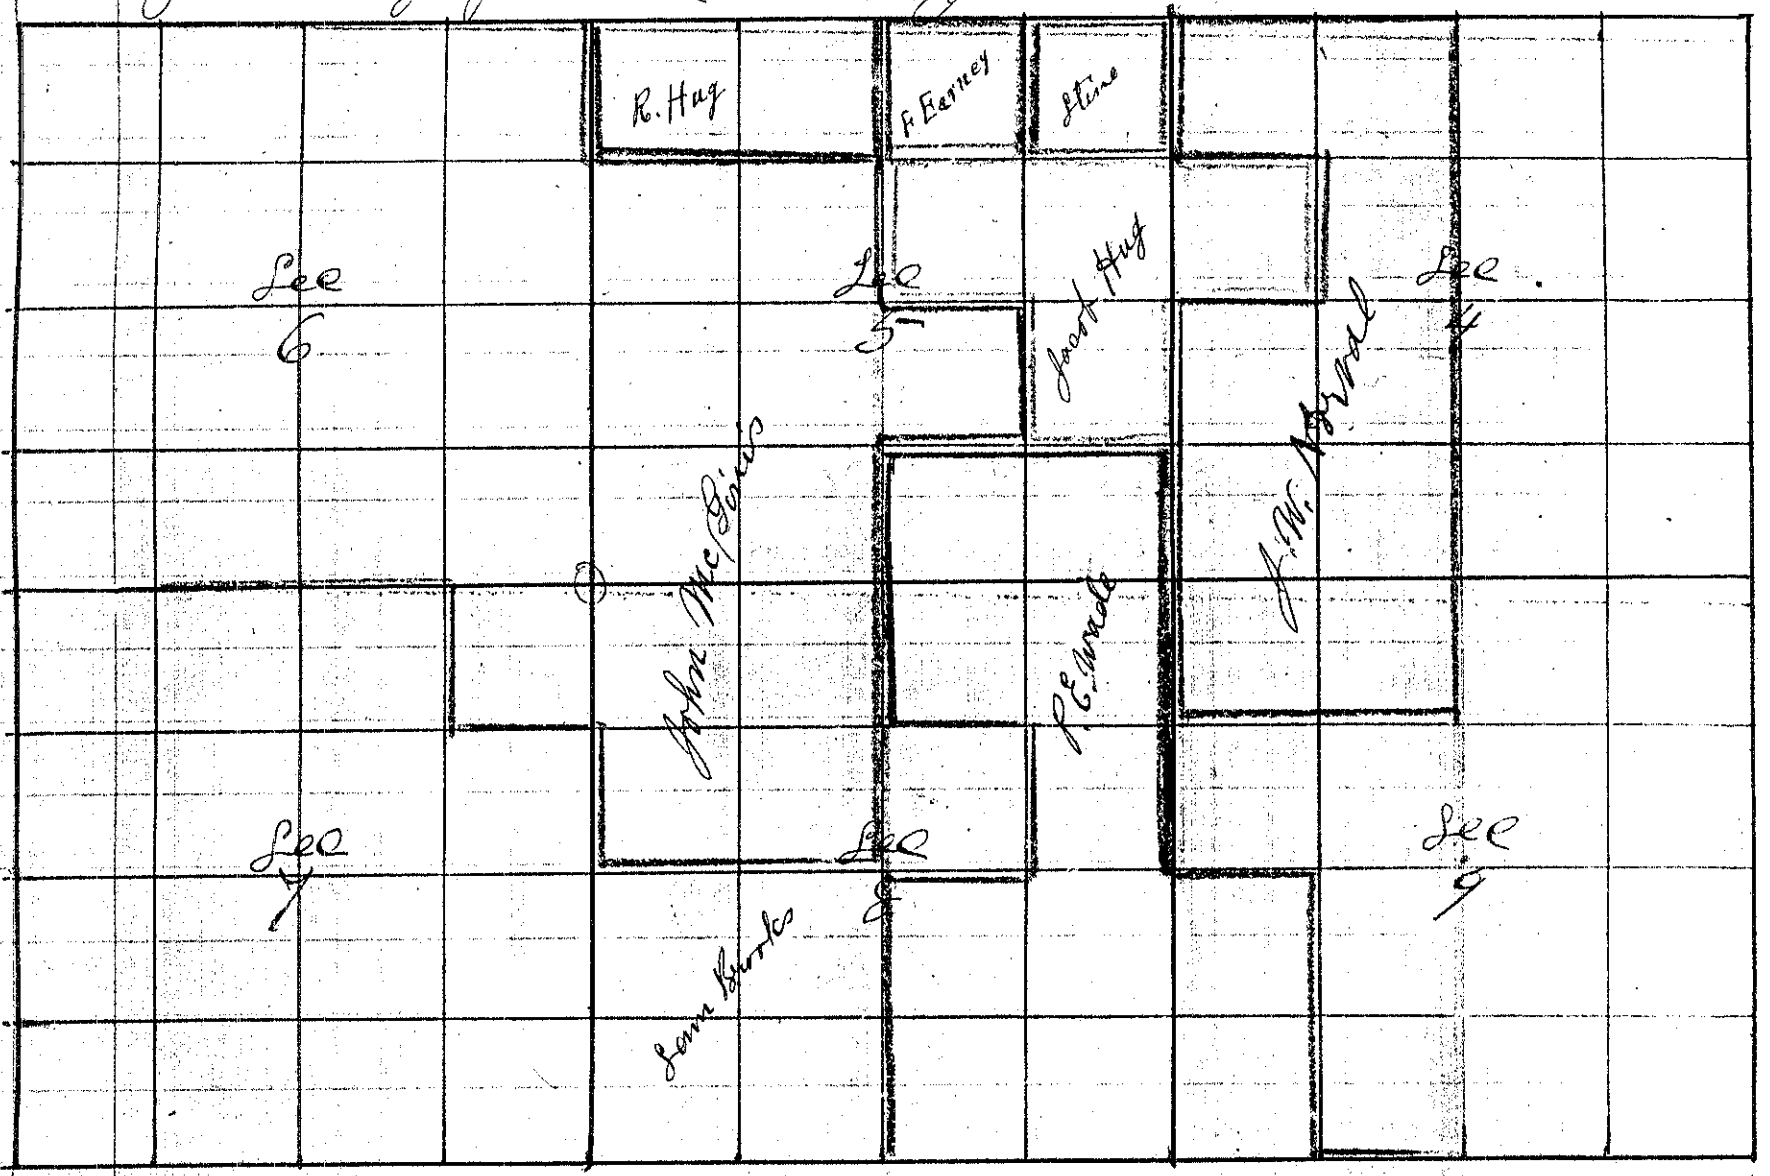

I commenced at the corner to Sec 4=5=8 & 9  
 on Base Line  
 thence South  $1^{\circ}30' E$  bet Sec 4 & 5  
 over  $20^{\circ} E$

- 19 64 Set temporary  $\frac{1}{8}$  corner
- 39 64 Set temporary  $\frac{1}{4}$  Sec corner
- 59 64 Sec temporary  $\frac{1}{8}$  corner
- 79 64 Intersect - 9 lks west of corner to Sec 4=5=8 & 9  
 Post decayed Set Stone  $6 \times 10 \times 26$  ft corner to Sec 4=5=8 & 9  
 thence  $N 1^{\circ}34' W$  on true line bet Sec 4 & 5  
 over  $20^{\circ} E$
- 20 00 Set Stone  $6 \times 9 \times 23$  for  $\frac{1}{8}$  corner
- 40 00 Set Stone  $6 \times 9 \times 22$  for  $\frac{1}{4}$  Sec cor bet Sec 4 & 5
- 60 00 Set Stone  $6 \times 8 \times 36$  for  $\frac{1}{8}$  corner
- 79 64 The corner to Sec 4=5=8 & 9

The corner to Sec 4=5=8 & 9  
 thence west bet Sec 5 & 8  
 over  $20^{\circ} E$

- 20 00 Set temporary  $\frac{1}{8}$  cor
- 40 00 Set temporary  $\frac{1}{4}$  Sec corner
- 80 95 The corner to Sec 5=6=7 & 8 in Marsh  
 Post decayed. Set Stone  $6 \times 16 \times 20$  for corner to Sec 5=6=7 & 8

Township 1 South Range 39 East Union County, Oregon.

Hence East bet Sec 5 & 8

- 40 71 1/2 Set Stone 8 x 16 x 25 for 1/4 Sec cor bet Sec 5 & 8
- 60 70 Set Post for 1/8 cor
- 80 95 The cor to Sec 4 = 5 = 8 & 9

The corner to Sec 5 = 6 = 7 & 8  
Hence north R.W. bet Sec 5 & 6  
for 20° E

- 20 50 Set Temporary 1/8 cor
- 45 50 Set Temporary 1/4 Sec cor
- 00 50 Set Temporary 1/8 cor
- 79 48 Intersect North Boundary 25 lks East of Cor to Sec 5 = 6 = 31 & 32  
Hence S 1° 11' E on Line bet Sec 5 & 6

- 19 27 Set Stone 4 x 12 x 27 for 1/8 cor
- 39 34 Set Stone for 1/4 Sec cor bet Sec 5 & 6
- 59 41 Set " " 1/8 cor
- 79 48 The cor to Sec 5 = 6 = 7 & 8

The corner to Sec 5 = 6 = 31 & 32 on Base Line  
Hence East on Base Line bet Sec 5 & 32  
for 19° E

- 40 06 The 1/4 Sec cor bet Sec 5 & 32  
Hence west
- 20 08 Set Stone 5 x 7 x 30 for 1/8 cor

The 1/4 Sec cor bet Sec 5 & 32  
Hence East on Base line bet Sec 5 & 32  
for 19° E

- 40 09 The Cor to Sec 4 = 5 = 32 & 33  
Hence West to Sec 5 & 32

- 20 04 1/2 Set Stone in mound of Stone in dry bed of Branch  
for 1/8 corner

The 1/4 Sec corner bet Sec 5 & 6  
Hence East through Sec 5  
for 20° E

- 40 50 Set Temporary Center Sec 5 -
- 65 50 Set Temporary 1/16 corner
- 80 60 Intersect at 1/4 Sec cor bet Sec 4 & 5 -

CHAINS.	LKS.	
		Hence West Through Center Sec 5-
20	15	Set Stone 5 x 12 x 24 for $\frac{1}{16}$ cor in center $\text{E} \frac{1}{2}$ Sec 5-
40	30	Set Stone 6 x 7 x 24 for center Sec 5-
80	60	The $\frac{1}{4}$ Sec cor bet Sec 5 & 6.
		The $\frac{1}{4}$ Sec corner bet Sec 5 & 8-
		Hence $\text{N} 1^{\circ} 22 \frac{1}{2}' \text{W}$ through Secs-
20	00	Set Temporary $\frac{1}{16}$ corner var $20^{\circ} \text{E}$
40	07	Intersect $\text{E} \frac{1}{2}$ W line at Center
60	07	Set Temporary $\frac{1}{16}$ corner
79	47	Intersect North Boundary at the $\frac{1}{4}$ Sec corner bet Sec 5 & 32
		Hence $\text{S} 1^{\circ} 22 \frac{1}{2}' \text{E}$ on true line through center Sec 5-
		var $20^{\circ} \text{E}$
19	40	Set Stone 11 x 13 x 32 in (Mound of Stone for $\frac{1}{16}$ corner, N $\frac{1}{4}$
39	40	The center Sec 5 a Stone 6 x 7 x 24
59	43 $\frac{1}{2}$	Set Stone 6 x 7 x 25 for $\frac{1}{16}$ cor in center $\text{S} \frac{1}{2}$ Sec 5-
79	47	
		The $\frac{1}{2}$ corner on East Boundary $\text{S} \frac{1}{2}$ Sec 5-
		Hence West through $\text{S} \frac{1}{2}$
		var $20^{\circ} \text{E}$
40	36	The $\frac{1}{16}$ corner in center $\text{S} \frac{1}{2}$
		Hence East-
20	18	Set Stone 4 x 6 x 24 for $\frac{1}{16}$ corner in center $\text{S} \frac{1}{4}$ Sec 5-
		The $\frac{1}{2}$ corner on East Boundary N $\frac{1}{2}$ Sec 5-
		Hence West through Center N $\frac{1}{2}$ Sec 5-
		var $23 \frac{1}{4}' \text{E}$
20	00	Set Temporary $\frac{1}{16}$ corner
40	16	Intersect N $\frac{1}{2}$ S line at Center N $\frac{1}{2}$
80	30	Intersect at the $\frac{1}{2}$ corner on West Boundary
		Hence East through Center N $\frac{1}{2}$ Sec 5-
40	14	Center N $\frac{1}{2}$ Sec 5 - a Stone 16 x 13 x 32
60	22	Set Stone $3 \frac{1}{2}$ x 10 x 25 for $\frac{1}{16}$ corner in center N $\frac{1}{4}$ Sec 5-
80	30	The $\frac{1}{2}$ corner on East Boundary N $\frac{1}{4}$ Sec 5-
		The $\frac{1}{2}$ corner on South $\text{S} \frac{1}{4}$ Sec 5-
		Hence North $1^{\circ} 28' 00''$ through $\text{E} \frac{1}{2}$ Sec 5-
20	00	The $\frac{1}{16}$ corner in center $\text{S} \frac{1}{4}$
40	03	The $\frac{1}{16}$ corner in center $\text{E} \frac{1}{2}$
60	06	The $\frac{1}{16}$ corner in center N $\frac{1}{4}$
79	56	The $\frac{1}{2}$ corner on North Boundary N $\frac{1}{4}$ Sec 5-

CHAINS  
Lks.

The 1/4 Sec corner bet Sec 4 & 5  
Thence East through Sec 4  
Var 20° E

- 20 00 Set Temporary 1/16 corner
- 70 53 Set Temporary center Sec 4
- 50 20 Intersect - 30 lks South of the 1/4 Sec cor bet Sec 3 & 4  
Thence S 89° 47' W on True line
- 20 17 Set Post in Mound of Stone for 1/16 cor in Center E 1/2 Sec 4
- 40 07 The center Sec 4
- 60 01 The center W 1/2 Sec 4
- 80 20 The 1/4 Sec cor bet Sec 4 & 5 -

The 1/4 Sec cor bet Sec 4 & 33 on Base Line  
Thence S 2° E through Sec 4  
Var 20° E

- 33 34 Top of Berkeley Bluff Telescope measurement 638 lks to flag
- 39 81 Intersect - E & W line 5 lks East of first stake at center
- 79 98 Intersect - 22 lks East of the 1/4 Sec corner bet Sec 4 & 9

The 1/8 corner on South Boundary S W 1/4 Sec 4  
Thence North 2° W through Center W 1/2 Sec 4

- 40 10 Intersect - E & W line 9 1/2 lks East of first stake.
- 60 10 Set Temporary 1/16 corner
- 79 60 Intersect North Boundary at 1/8 cor  
Thence South 2° E

- 19 47 Set Stone 7 x 11 x 25 for 1/16 cor in Center NW 1/4 Sec 4
- 39 50 Set Stone 3 x 7 x 36 for 1/16 cor in Center W 1/2 Sec 4

The corner to Sec 5 = 6 = 7 & 8  
Thence West bet Sec 6 & 7  
Var 20° E

- 40 00 Set Temporary 1/4 Sec corner
- 79 10 Intersect West Boundary 18 lks South of corner to Sec 6 = 7 = 8  
Thence S 89° 55' E on True line bet Sec 6 & 7
- 38 60 Set Stone 4 x 16 x 22 for 1/4 Sec corner bet Sec 6 & 7
- 79 10 The corner to Sec 5 = 6 = 7 & 8

J. W. Kimball County Surveyor