

RECORD OF SURVEY

No 98

Township 1 South


Range 39 of 40 East W.M. Union County, Oregon.

CHAINS

LKS.

J.W. Bault Joel Weaver & Sol. Sturgis Nov 19 1889

The corner to Sec 1-6-7 1/2
 and the 1/4 Sec corner bet Sec 7 & 6
 on a Guide Meridian bet.
 Ranges 39 & 40 East W.M.
 Township 1 South
 being out of place
 I proceeded to reestablish
 the same as follows

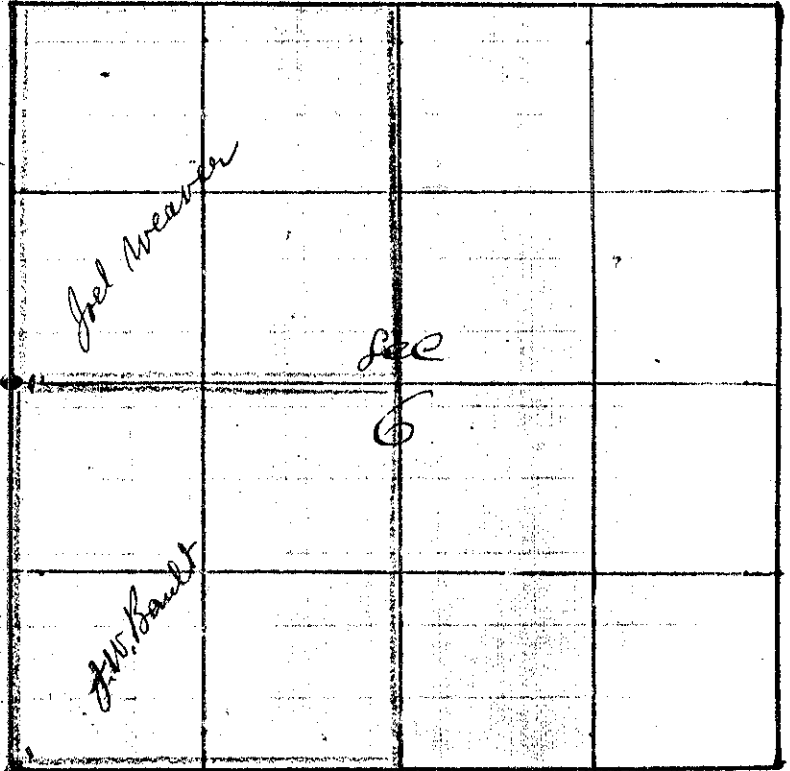

at the corner to Sec 1-6-7 1/2
 I set a Stone 6 x 7 x 18 inches
 from which
 a Pine 30 inches dia, to S 20° E 274 lks dist.
 " 42 " " " S 42° W 427 " "

at the 1/4 Sec corner bet Sec 1 & 6
 I set Stone 8 x 8 x 22 inches
 from which
 a Pine 30 inches dia, to N 87° W 149 lks dist
 " 20 " " " S 25° W 127 " "
 having been cut down and decaying

I marked
 a Pine 8 inches dia, to N 82° E 247 lks dist.
 " 5 " " " S 7° W 203 " "

J.W. Kimbrell County Surveyor