


Township 6 South

Range 38 East W M

Union County, Oregon.

CHAINS  
LKS.

John Henderson Joe Harrison & B.W. Solan Dec. 7 1889

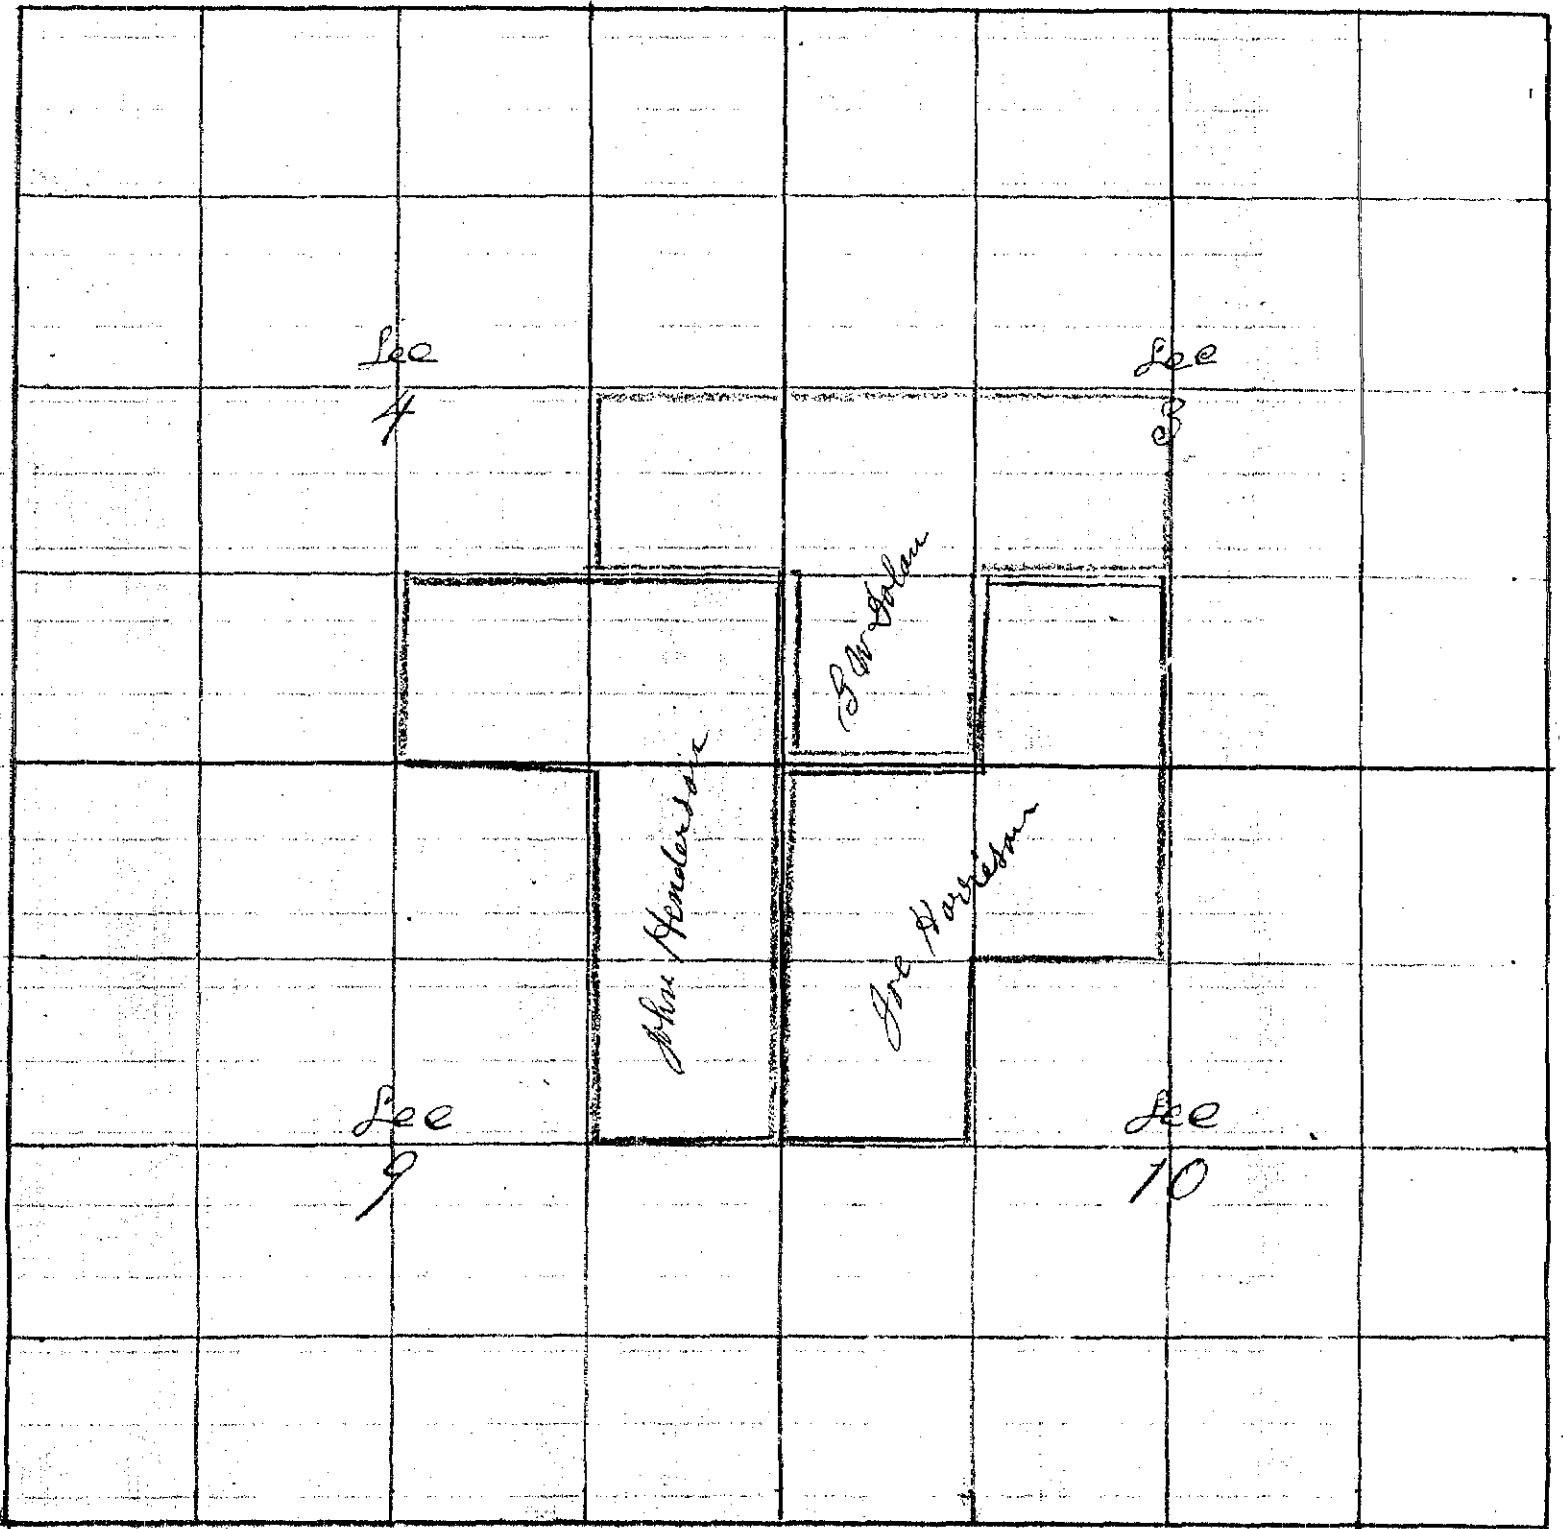

I commenced at the corner to Sec 3=4=9 & 10  
 Re Set Post corner  
 from which

- a Pine 36 inches dia. brs S 83° W 117 lks dist.
- " 44 " " " N 83° W 188 " "
- " 36 " " " S 79° E 212 " "
- " 36 " " " N 48° E 234 " "

thence South bet Sec 9 & 10  
 Var 18° 30' E

20 00 Set Temporary 1/2 corner

39 25 Intersect - 12 lks East of the 1/2 dia cor bet Sec 9 & 10  
 from which

- a Pine 15 inch dia. brs N 42 1/2° E 131 lks dist.
- " 30 " " " N 54° W 115 " "

thence N 10° E on same line

19 62 1/2 Set Post for 1/2 corner

from which  
 a Pine 20 inch dia brs N 51° E 126 lks dist  
 39 25 the corner to Sec 3=4=9 & 10

CHAINS	LINKS	DESCRIPTION
		The corner to Sec 3=4=9 & 10 Thence North bet Sec 3 & 4 Var 19° 30' E
15	57	ascend steep Hill Side 309 lks to foot of Hill
20	00	Set Temporary 1/8 corner
23	75	Wolfcreek 15 lks across
24	75	ascend steep Hillside
39	40	Intersect - 16 lks East of 1/4 Sec corner bet Sec 3 & 4 Thence South 14' E on true line
14	70	Set Post for 1/8 corner from which an alder 5 inch dia bet S 19° W 12 lks dist " 5 " " " N 8 1/2° W 2 1/2 " "
59	40	The corner to Sec 3=4=9 & 10 Thence West bet Sec 4 & 9 Var 20° E
20	00	Set Temporary 1/8 corner
40	76	Intersect - 34 lks North of 1/4 Sec corner bet Sec 4 & 9 from which a Pine 2.5 inch dia bet N 20° E 24 lks dist Tamarack 14 " " " S 5° E 43 " "
20	38	Set Post for 1/8 corner from which a Pine 5 inch dia bet S 29° E 102 lks dist.
40	76	The corner to Sec 3=4=9 & 10 Thence East bet Sec 3 & 10 Var 20° E
20	00	Set Temporary 1/8 corner
40	70	The 1/4 Sec corner bet Sec 3 & 10 Thence West
20	35	Set Post for 1/8 corner
40	70	The corner to Sec 3=4=9 & 10
		The corner to Sec 2=3=34 & 35 On 1 <sup>st</sup> Standard Parallel South bet T 5 & 6 S Thence West bet Sec 3 & 34 var 20° E
80	85	The corner to Sec 3=4=33 & 34 Thence East bet Sec 3 & 34
40	42 1/2	Set Post for 1/4 Sec corner bet Sec 3 & 34 on SW Slope of Hill
80	85	The corner to Sec 2=3=34 & 35

CHAINS.	LINKS.	
		The 1/4 Sec corner bet Sec 3 & 10 Thence North through Sec 3 Var 20° E
12	50	Descend steep Hill side
18	00	foot of Hill
20	00	Set Temporary 1/16 corner
23	00	Wolf creek runs East
35	00	Clear creek Course S E
40	00	Set Temporary Center Sec 3
77	39	Intersect - 30.2 lks East of 1/4 Sec corner bet Sec 3 & 34 Thence S 2° 10' E on true line through Sec 3
		The 1/4 Sec corner bet Sec 3 & 4 Thence East through Sec 3 Var 20° E
36	50	Clear creek Course S E
39	24	Intersect - True N & S line 23 lks South of first Stake at center
82	34	Intersect - 195 lks North of 1/4 Sec corner bet Sec 2 & 3 Thence N 88° 24' W on true line through Sec 3
43	10	Set Post for center in mound of Stone from which a Sawrack 12 inches dia by N 18 1/2° W 75 lks dist Thence South through S 1/2 Sec 3
19	42 1/2	Set Post for 1/16 corner in center S 1/2 Sec 3 Thence west through S W 1/4 Sec 3 Var 20° E
20	00	Set Temporary 1/16 corner
40	06	Intersect 43 lks South of 1/8 corner on W by S W 1/4 Sec 3 Thence S 88° 40' E on true line through S W 1/4
20	03	Set Post for 1/16 corner in center S W 1/4 Sec 3 from which a fir 5 inch dia tree S 76° W 65 lks dist
		The 1/4 Sec corner bet Sec 3 & 4 Thence west through Sec 4 Var 20° E
20	00	Set Temporary 1/16 corner
26	00	Wolf creek runs S E
28	00	Shingle Patch runs N E
40	00	Set Temporary center
82	00	Intersect 100 lks South of 1/4 Sec corner bet Sec 4 & 5 Thence S 89° 17' E on true line through Sec 3

Township 6 South

Range 38 East

Union County, Oregon.

The  $\frac{1}{4}$  Sec Corner bet Sec 4 of 38 on 1<sup>st</sup> Standard Parallel South  
 Hence South through Sec 4  
 Var  $21^{\circ}$  E

- 20 50 Woolf Creek  
 41 63 Intersect E & W line 90 lks west of first Temporary Station at Center  
 61 63 Set Temporary  $\frac{1}{16}$  corner  
 51 85 Intersect 216 lks East of  $\frac{1}{4}$  Sec Corner bet Sec 4 & 9  
 Hence  $N 1^{\circ} 33' E$  on same line  
 19 86 Set Post for  $\frac{1}{16}$  corner in center S  $\frac{1}{2}$  Sec 4  
 39 72 Set Post for center Sec 4

from which  
 a Pine 9 inches dia bet  $S 9\frac{1}{2}^{\circ} W$  20 lks dist  
 fir 20 " " "  $N 20^{\circ} W$  20 " "

- 20 68 Set Post for  $\frac{1}{16}$  corner in center E  $\frac{1}{2}$  Sec 4  
 from which

a Sawrack 5 inches dia bears North 35 lks

The  $\frac{1}{8}$  corner on East Boundary S E  $\frac{1}{4}$  Sec 4  
 Hence West through S E  $\frac{1}{4}$

- 20 55 Set Temporary  $\frac{1}{16}$  corner  
 41 21 Intersect 7 lks South of  $\frac{1}{16}$  corner in center S  $\frac{1}{2}$  Sec 4  
 Hence  $S 89^{\circ} 54' E$  on same line through S E  $\frac{1}{4}$   
 20 60 Set Post for  $\frac{1}{16}$  corner in center S E  $\frac{1}{4}$  Sec 4

from which  
 a Sawrack 6 inches dia, bet  $N 70^{\circ} E$  25 lks dist-

J. W. Kimball County Surveyor