

Township 2 South


Range 37 East W. M.

Union County, Oregon.

Clarence Eaton

April the 9th 1890

I commenced at the corner to
 Sec 26 = 27 = 34 & 35
 a Boulder 4 feet square from which
 a Pine 12 inch dia. brs S 35° W 288 lks dist
 " 36 " " " N 41° W 218 " "
 " 36 " " " N 32° E 195 " "
 thence East bet Sec 26 & 35 -
 var 20° E

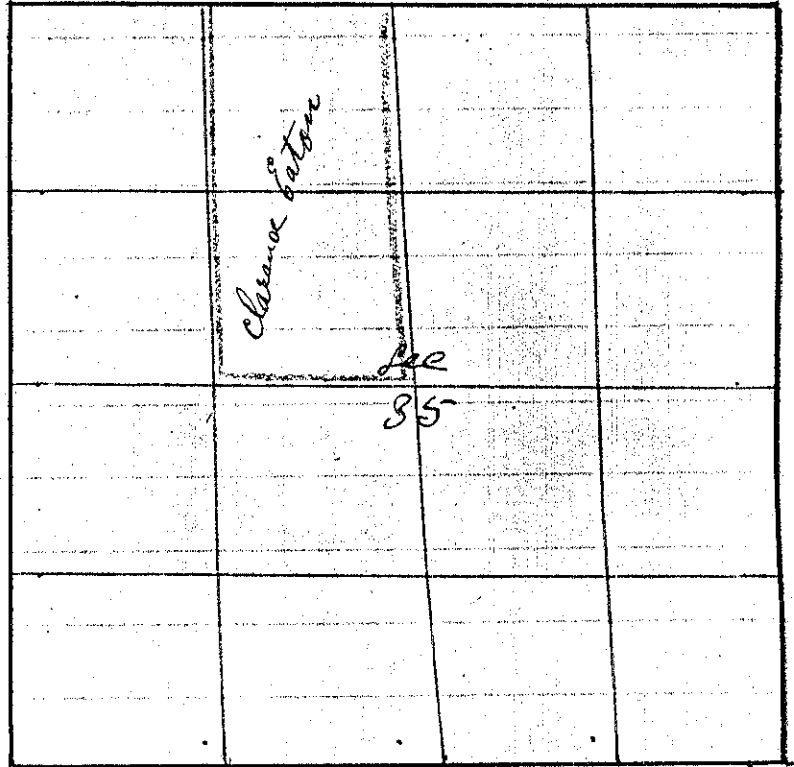

ascend S W Slope of Hill
 6 00 Top of Hill Sloping to the South
 20 50 Set Temporary 1/8 corner
 descend S E
 25 50 Ravine Course South
 ascend
 41 07 Intersect 187 lks South of the 1/4 Sec bet Sec 26 & 35 -
 thence S 88° 18' W on True line bet Sec 26 & 35 -
 20 53 1/2 Set Post for 1/8 corner
 41 07 The corner to Sec 26 = 27 = 34 & 35 -

The 1/4 Sec Corner bet Sec 26 & 35
 thence South through Sec 35

descend gradual to the South

16 00 Road S E ascend
 20 00 Set Temporary 1/6 corner
 25 00 Top of Ridge Course N E & S W
 40 00 Set Temporary center Sec 14
 43 50 Rail Road N E & S W
 45 50 Grand Round River Bottom
 46 52 " " " 25 lks across Course N E
 82 72 Intersect South Boundary 510 lks west of 1/4 Sec corner bet Sec 35 & 36
 from which
 a fir 5 inches dia. brs S 85 1/2° E 120 lks dist
 thence N 3° 37' W on True line through Sec 35 -

The 1/4 Sec Corner bet Sec 2 & 35 -

thence west bet Sec 2 & 35 -

var 20° E

20 00 Set Temporary 1/8 corner
 44 60 Intersect the corner to Sec 2 = 3 = 34 & 35 -

Township 2 South

Range 37 East

Union County, Oregon.

CHAINS.

LKS.

- The corner to Sec 2-3-34 & 35 on T₁₀ line,
bet Townships 2 & 3 South
which is a Post in mound of Stone
Thence East on T₁₀ line
bet Sec 2 & 35-
- 22 30 Set Post in mound of Stone for $\frac{1}{8}$ corner
from which
a Pine 24 in dia N41° E 22 lks dist
" 22 " " S61° W 48 " "
- 44 60 The $\frac{1}{4}$ Sec corner bet Sec 2 & 35-
- The $\frac{1}{8}$ corner on South Boundary of NW $\frac{1}{4}$ Sec 35-
thence North 1° 48' W
var 15° E
- 23 48 Top of Rock Bluff
ascend
- 5 30 var 22° E
- 17 00 var 17° 30' E
- 15 00 var 22° 30' E
- 21 50 Grande Round 230 lks across course N 80° E
var 22° E
- 30 48 Top of Ridge
- 31 75 Rail Road E & W
- 33 00 Through 410 lks across
- 40 00 Set Temporary center W $\frac{1}{2}$ Sec 35-
- 73 00 ascend steep South Hillside.
- 81 00 Intersect $\frac{1}{8}$ corner on North Boundary NW $\frac{1}{4}$ Sec 35-
thence South through NW $\frac{1}{4}$ Sec 35-
- 40 50 center W $\frac{1}{2}$ Sec 35-
thence West through W $\frac{1}{2}$ NW $\frac{1}{4}$ Sec 35-
- 21 00 The $\frac{1}{4}$ Sec corner bet Sec 34 & 35 -
from which
a Pine 12 inch S63° E 32 lks dist
fir 5 " North 30 " "

J. W. Kimbrell