

Township 1 North

Range 40 East W M

Union County, Oregon.

Andrew Knight

April 19th 1890

I commenced at The corner
To Sec 1-6-7 1/2 on Guide
Meridian bet Ranges 39 & 40 East
Thence East bet Sec 6 & 7

Var 22° E

38 74 Set Temporary 1/4 Sec corner

58 74 Set Temporary 1/8 corner

80 55 Intersect 51 lbs North of corner

To Sec 5-6-7 1/8


Thence N 89° 38' (wonderline)

Var 22° E

20 45 Set Post for 1/8 corner

40 70 Set Stone 6 + 8 + 22 for 1/4 Sec corner bet Sec 6 & 7

50 55 The corner to Sec 6-7-1 1/2

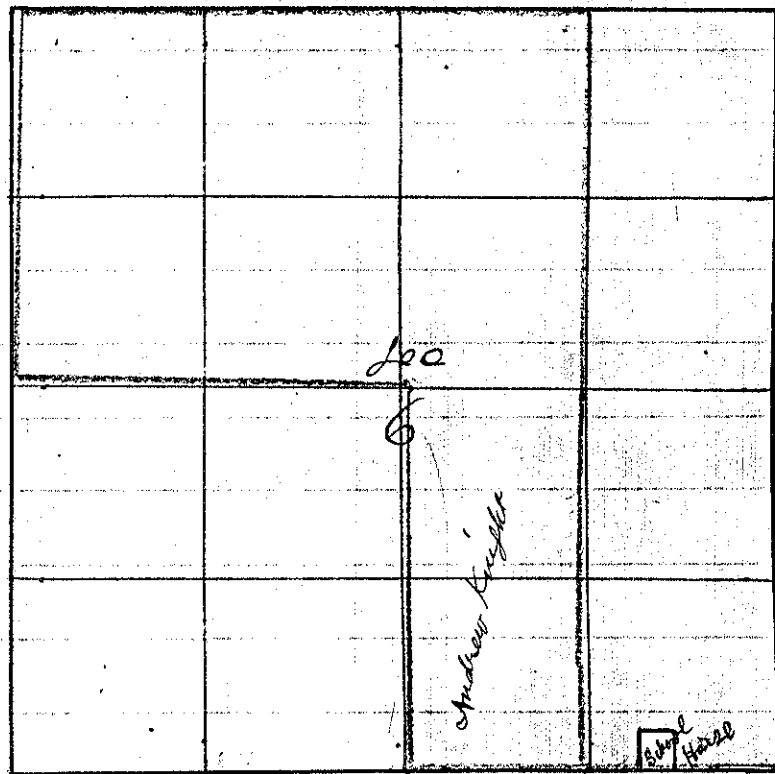

School House Lot for School Dist N 29

Commencing at a point on Sec Line bet Sec 6 & 7

45 Rods West of The corner To Sec 5-6-7 1/8

Thence North 13 Rods

" West 13 "

" South 13 "

" East 13 " To Place of Beginning

J. W. Mitchell County Surveyor

80.55
66
48 33
683 30
531 63