


Sam Charnes and John Bryant April 25th 1890

CHAINS. LKS.

I Commenced at the corner
of Sec 2-3-10 & 11
a post in mound of stone
thence East bet Sec 2 & 11

Var 20° E

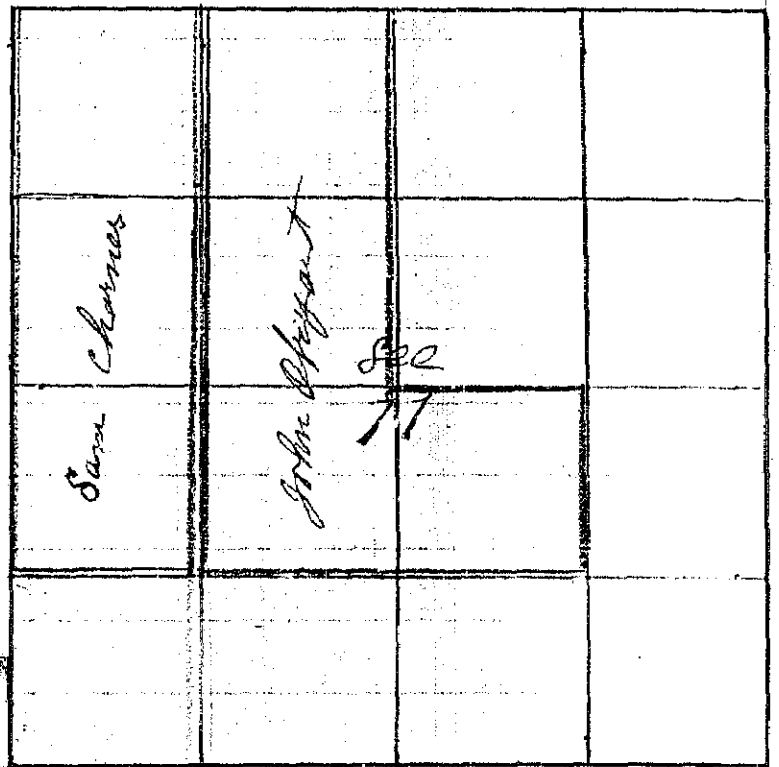

5 00 Wolf Creek 25 lks across S.W.

20 00 Set Temporary 1/8 corner

39 90 Intersect 90 lks South of 1/4

Sec Corner bet Sec 2 & 11

Post decayed Set Stone 6x7x15-

for 1/4 Sec bet Sec 2 & 11

thence S 89° 21' W on True Line

between Sec 2 & 11

19 95 Set Post in mound of Stone for 1/8 corner

39 90 The corner of Sec 2-3-10 & 11

The 1/4 Sec Corner bet Sec 10 & 11

thence South bet Sec 10 & 11

Var 19° E

20 00 Set Temporary 1/8 corner

39 97 The corner of Sec 10-11-14 & 15-

thence North bet Sec 10 & 11

19 98 1/2 Set Post for 1/8 corner

39 97 The 1/4 Sec corner bet Sec 10 & 11

thence East through Sec 11

Var 20° E

20 00 Set Temporary 1/16 corner

21 66 Wolf Creek 180 lks across course S & E

40 00 Set Temporary center Sec 11

60 00 Set Temporary 1/16 corner

80 85 Intersect 10 lks North of the 1/4 Sec corner bet Sec 11 & 12

thence N 89° 56' W on True line

The 1/4 Sec corner bet Sec 11 & 14

thence North through Sec 11

Var 20° E

20 00 Set Temporary 1/16 corner

26 00 Wolf Creek runs S & E

40 10 Intersect True E & W line 33 lks East of 1st Stake at center

80 43 The 1/4 Sec corner bet Sec 2 & 11

Township 6 South

Range 38 East

Union County, Oregon.

CHAINS. LRS.

- Thence South through Sec. 11
- 40 33 Set Post for center Sec 11
from which
a Pine 10 inch dia tree S 22 1/2° W 192 lks dist
- 60 38 The center S 1/2 Sec 11
Thence West through SW 1/4 Sec 11
- 40 46 The 1/8 corner on West Boundary SW 1/4 Sec 11
Thence East through center SW 1/4 Sec 11
var. 20° E
- 20 23 Set Post for 1/16 corner in center SW 1/4 Sec 11
The Corner to Sec 10 = 11 = 14 & 15
Thence East bet Sec 11 & 14
var 20° E
- 40 26 The 1/4 Sec corner bet Sec 11 & 14
Thence East bet Sec 11 & 14
var 40° E
- 20 00 Set Temporary 1/8 corner
- 37 50 The Corner to Sec 11 = 12 = 13 & 14
Thence West bet Sec 11 & 14
- 18 75 Set Post for 1/8 corner
Thence North through SE 1/4 Sec 11
- 20 00 Set Temporary 1/16 corner
- 39 75 Intersect 1/16 corner in center E 1/2 Sec 11
Thence South through center SE 1/4
- 19 87 1/2 Set Post for 1/16 corner in center SE 1/4 Sec 11
- 39 75 The 1/8 corner on South Boundary SE 1/4 Sec 11

J. W. Kimball County Surveyor