


Township 4 South Range 40 East W.M. Union County, Oregon.

Ed. Remillard

May the 3<sup>rd</sup> 1890

CHAINS. LKS.

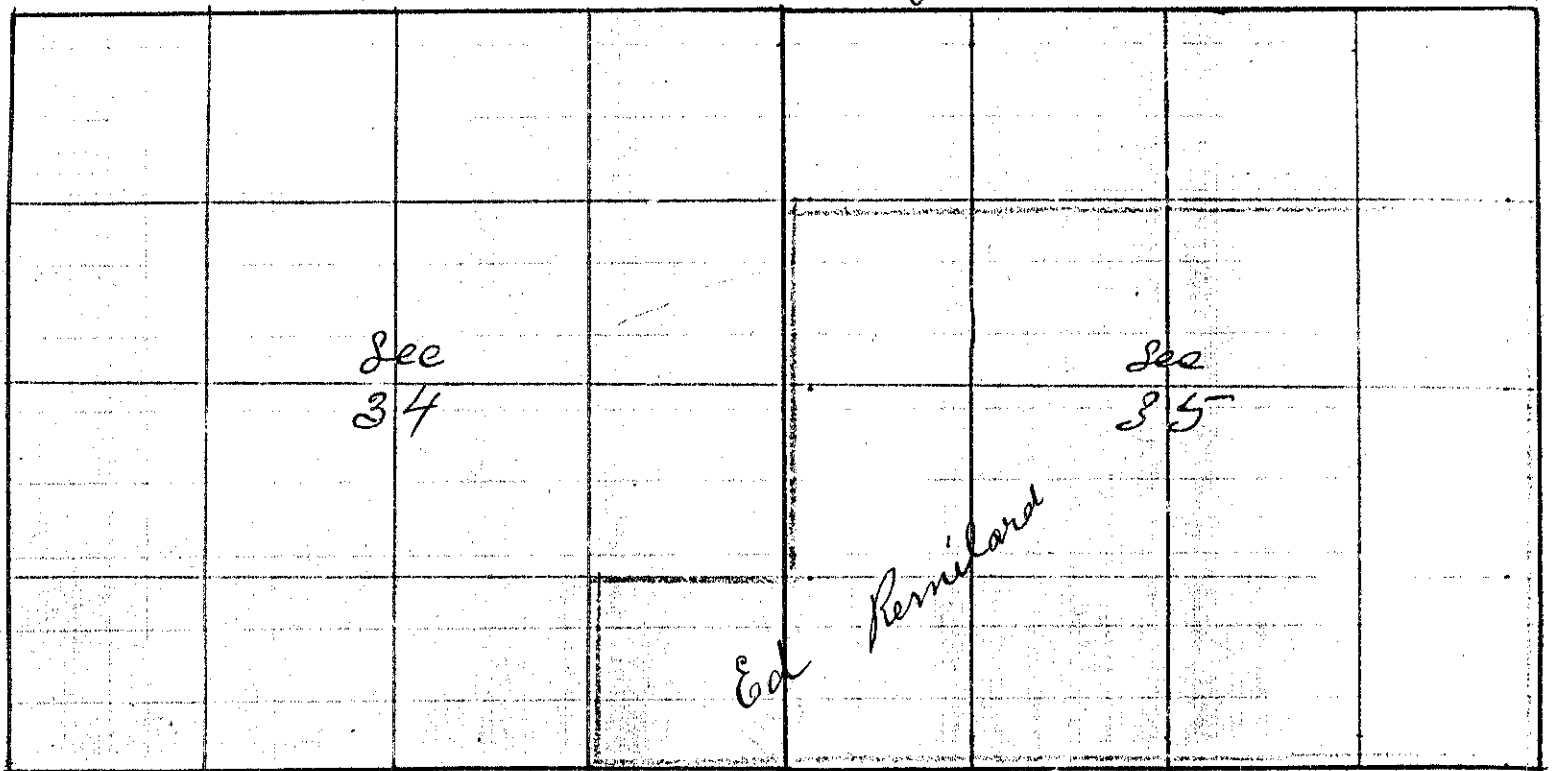

I Commenced at the corner of Sec 2 = 3 = 34 & 35 -  
 Thence East on Twp line bet Sec 2 & 35  
 Var  $20^{\circ}45' E$

40 35 the 1/4 Sec corner bet Sec 2 & 35 -  
 Thence North through Sec 35  
 Var  $20^{\circ}15' E$

80 10 Intersect 8 lks West of the 1/4 Sec corner bet Sec 26 & 35 -

The corner of Sec 26 = 27 = 34 & 35 -  
 Thence South bet Sec 34 & 35 -

39 68 Intersect 12 lks west of 1/4 Sec corner bet Sec 34 & 35 -  
 Thence North 11' on same line

The 1/4 Sec corner bet Sec 34 & 33  
 Thence South bet Sec 34 & 35 -  
 Var  $19^{\circ} E$

20 00 Set Temporary 1/4 corner

40 45 Intersect 12 lks West of corner of Sec 2 = 3 = 34 & 35 -  
 Thence N 19' W on same line bet Sec 34 & 35 -

20 22 1/2 Set Post in mound of Stone for 1/4 corner

40 45 the 1/4 Sec corner bet Sec 34 & 35 -

The corner of Sec 2 = 3 = 34 & 35 -  
 Thence West on Township line  
 bet Sec 2 & 34

Var  $20^{\circ}45' E$

Ascend

20 00 Set Temporary 1/4 corner

22 88 Right-Bank of Catherine Creek Course  $N 85^{\circ} W$

Township

Range

Union County, Oregon.

- 28 28 Left Bank of Catherine Creek Course  $N 85^{\circ} W$   
 35 45 a Stone marked 14 but not set firmly in the ground  
 and from all appearances has been moved from its original position  
 and as there is such a difference in the distance between it and the  
 corner to Sec 2-3-34 & 35 and bet it and Catherine Creek  
 as per U S Field Notes that I proceed on west  
 to test the correctness of its position
- 40 00 Set Temporary  $\frac{1}{4}$  Sec corner  
 79 67 Intersect 26 lbs north of corner of Sec 3-4-33 & 34  
 Thence  $N 89^{\circ} 49'$  E on same line  
 Var  $20^{\circ} 45'$  E
- 39 83 Set Stake for  $\frac{1}{4}$  Sec corner of Sec 3 & 34  
 Thence North through Sec 34
- 19 00 Catherine Creek Course N.W.  
 20 00 Right Bank of Catherine Creek  
 Thence East through Sect  $E \frac{1}{2}$  Sec 34
- 39 02 Intersect 20 lbs north of  $\frac{1}{8}$  corner on E Boundary of  $E \frac{1}{4}$  Sec 34  
 Thence  $N 89^{\circ} 48'$  west on same line
- 19 51 Set Post in mound of Stone for  $\frac{1}{16}$  corner in Center  $S W \frac{1}{4}$  Sec 34

J W Kimball County Surveyor