

May the 16<sup>th</sup> 1890

Charles Wilson

I commenced at the  
1/4 Sec corner bet Sec 2 & 11  
Corner out of Place

I Set Stone 9+14+20 inches  
for 1/4 Sec corner bet Sec 2 & 11  
from which

a Pine 8 inches dia. by N 65° W 100 lks dist.  
Thence North 11° 50' W through  
Sec 2

Var 20° E

16 76 Top of Bluff on South Side  
of Catherine Creek 232 lks to  
North Bank of Catherine Creek

20 00 Set Temporary 1/6 corner

37 58 Intersect 44 lks East of center  
Sec 2 a Stone marked CS in end of stone  
Thence S 14° E Var 20° E

18 79 1/6 corner in center of Catherine Creek  
I drove a 3/4 inch Iron Bolt  
11 inches long in the End Log  
for witness corner 26 lks North  
of True corner in Catherine Creek

from which  
a Pine 34 inches dia. by S 18° E 190 lks dist.

37 58 The 1/4 Sec corner bet Sec 2 & 11

The corner fr Sec 1 = 2 = 11 & 12

Thence North bet Sec 1 & 2

Var 19° 45' E

4 21 Catherine Creek 118 lks across course N 80° W

20 00 Set Temporary 1/8 corner

39 63 Intersect 6 lks West of 1/4 Sec corner bet Sec 1 & 2  
Thence South

19 8 1/2 Set 6+10+23 for 1/8 corner

39 63 The corner fr Sec 1 = 2 = 11 & 12


Thence South bet Sec 11 & 12

Var 19° 30' E

40 00 Intersect 65 lks East of 1/4 Sec corner bet Sec 11 & 12

Thence North 56° E on same line

20 00 Set Post for 1/8 corner

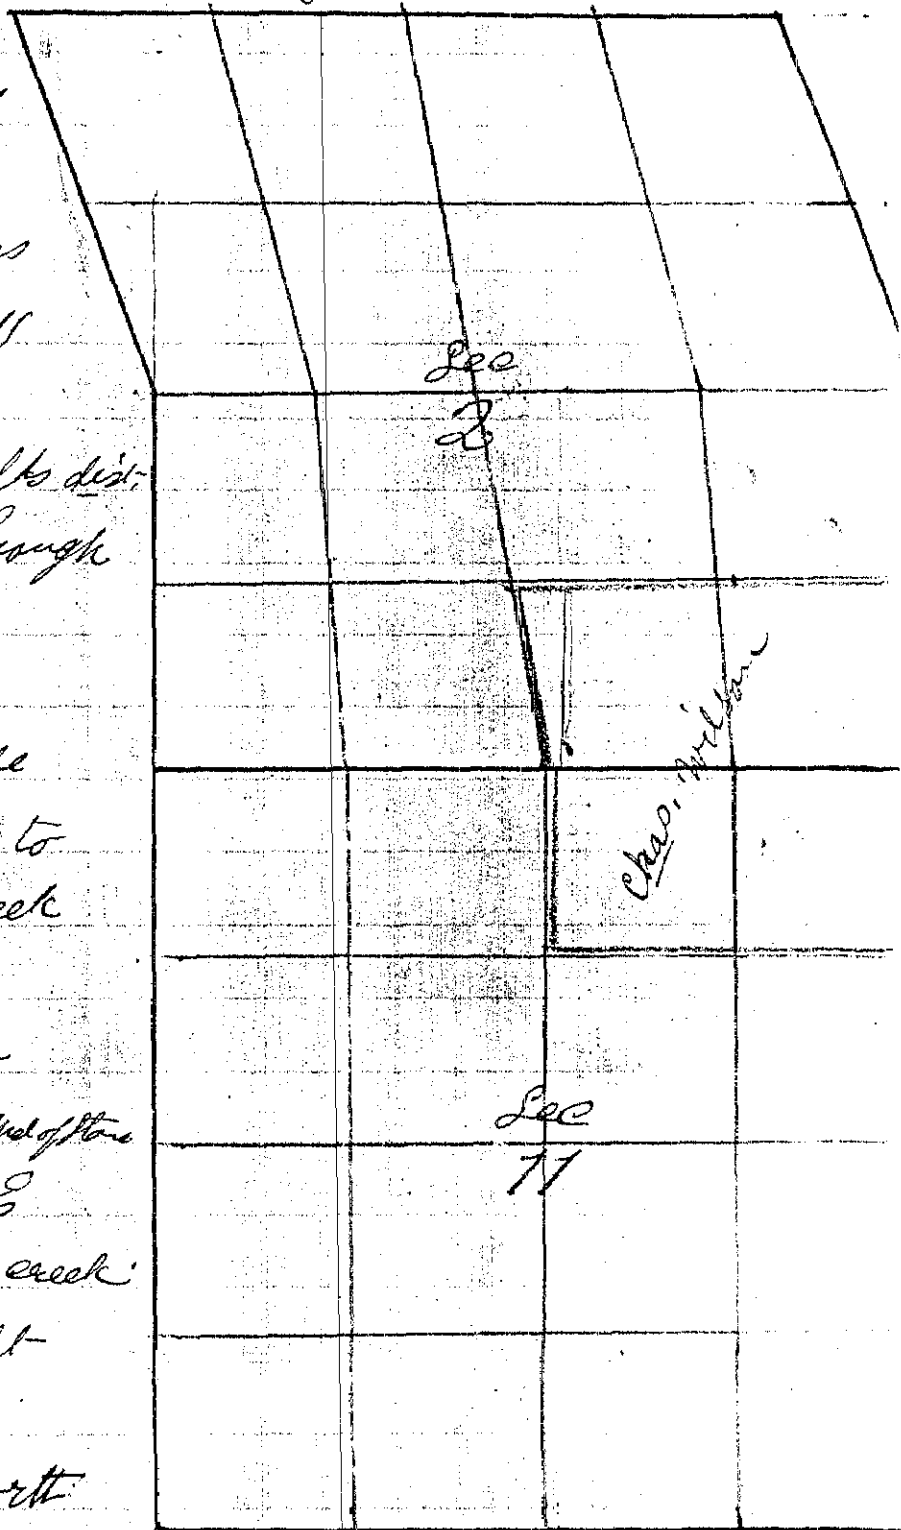

Township 5 South

Range 40 East

Union County, Oregon.

CHAINS  
FMS.

from which  
a Pine 20 inches dia. bes  $S 49^{\circ} W 52$  lks dist.  
" 20 " " " "  $N 26^{\circ} W 57$  " "  
The corner to Sec 1-2-11 & 12

The  $\frac{1}{4}$  Sec corner bet Sec 11 & 12  
Thence west through Sec 11  
Var  $20^{\circ} E$

40 00 Set Temporary center Sec 11

80 15 Intersect - 147 lks South of  $\frac{1}{4}$  Sec corner bet Sec 10 & 11  
Thence  $S 88^{\circ} 57' E$  on June line through Sec 11

The  $\frac{1}{4}$  Sec corner bet Sec 2 & 11  
Thence South through Sec 11  
Var  $20^{\circ} 30' E$

20 00 Set Temporary  $\frac{1}{16}$  corner

39 55 Intersect - June E & W line 51 lks East of 1<sup>st</sup> Stake at center

80 83 Intersect - 14 lks west of the  $\frac{1}{4}$  Sec corner bet Sec 11 & 14  
Thence  $N 6^{\circ} W$  through Sec 11

41 28 The center Sec 11

61 07 Set Stone  $12 \times 12 \times 24$  for  $\frac{1}{16}$  corner in center  $N \frac{1}{2}$  Sec 11  
Thence East through  $N \frac{1}{4}$  Sec 11

39 87 Intersect - 36 lks North of  $\frac{1}{8}$  corner on East bdy  $N \frac{1}{4}$  Sec 11  
Thence  $N 89^{\circ} 29' W$  on June line

through center  $N \frac{1}{4}$  Sec 11

37 84 The  $\frac{1}{16}$  corner in center  $N \frac{1}{2}$  Sec 11

Submittal County Surveys