


CHAINS
LRS.

John Elliot and Chas. Harris May 26 1870
 I commenced at the 1/4 Sec
 Corner bet Sec 25 & 3 on
 Guide Meridian bet Ranges
 39 & 40 East

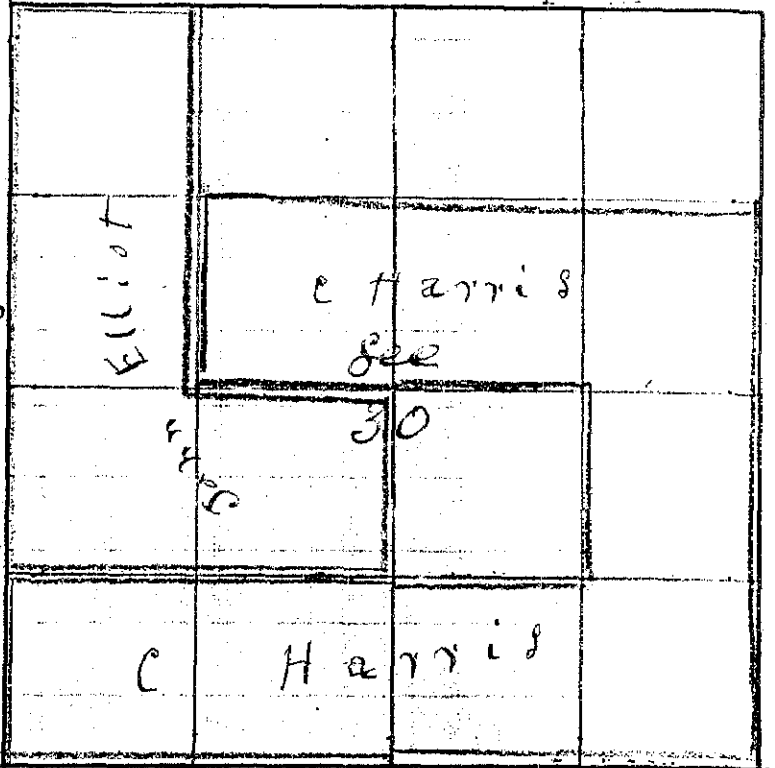

Hence South bet Sec 25 & 30
 Var $22^{\circ} 55' E$

20 50 Set Temporary 1/8 corner

40 10 Intersect the corner to Sec 30 = 31 = 25 & 36

Hence North

20 05 Set Stone 6 x 12 x 20 inch for 1/8 cor.

40 10 The 1/4 Sec corner bet Sec 30 & 25 -

The 1/4 Sec corner bet Sec 30 & 31

from which

a Pine 12 inch dia. bet S $61^{\circ} W$ 24 lks dist.

Hence North through Sec 30

Var $20^{\circ} E$

73 27 North Hillside on South Side of Clark's Creek

20 00 Set Temporary 1/16 corner on North Side Clark's Creek

40 00 Set Temporary center Sec 30

80 20 Intersect 700 lks West of 1/4 Sec corner bet Sec 19 & 30

Hence S $5^{\circ} W$ on True line var $20^{\circ} E$

The corner to Sec 19 = 30 = 24 & 25 -

Hence East bet Sec 19 & 30

Var $21^{\circ} E$

19 54 Set Temporary 1/8 corner

40 38 Intersect 28 lks South of 1/4 Sec corner bet Sec 19 & 30

Hence S $89^{\circ} 36' W$ on True line

20 42 Set Post in mound of Stone for 1/8 corner in ravine Course $S 35^{\circ} W$

from which

a Hawthorn 3 inch dia. bet S $28^{\circ} E$ 7 lks dist

40 38 The corner to Sec 19 = 30 = 24 & 25 -

The 1/4 Sec corner bet Sec 29 & 30

Hence West through Sec 30

Var $21^{\circ} E$

44 76 Intersect True N & S line 112 lks South of 7th Stake at Center

64 56 Set Temporary 1/16 corner

81 90 Intersect 55 lks South of 1/4 Sec corner bet Sec 25 & 30

Township 7 North

Range 40 East

Union County, Oregon.

CHAINS LKS.

- Thence $S 89^{\circ} 36' E$ on true line through Sec 30
- 17 40 Set Post for $\frac{1}{16}$ corner in center $W \frac{1}{2}$ Sec 30 ^{from which} a Hawthorn 4 in dia $S 2^{\circ} W$ 12 lks dist
- 37 14 Set stone 9 + 17 + 34 in mound of stone for center Sec 30
- Thence South through $S \frac{1}{2}$ Sec 30
- 19 57 The $\frac{1}{16}$ corner in center of $S \frac{1}{2}$ Sec 30 in center of Clark's creek from which
- an alder 6 inch dia $N 1 \frac{1}{2}^{\circ} W$ 15 lks dist
- " 4 " " " $N 17^{\circ} E$ 18 " "
- 39 15 The $\frac{1}{4}$ Sec corner bet Sec 30 & 31
- The corner to Sec 30 = 31 = 25 & 36
- Thence East - bet Sec 30 & 31
- 19 72 Set Temporary $\frac{1}{8}$ corner ^{var $2 \frac{1}{2}^{\circ} E$}
- 33 12 Intersect $\frac{1}{4}$ Sec corner bet Sec 30 & 31
- Thence west - bet Sec 30 & 31
- 16 70 Set Post for $\frac{1}{8}$ corner
- Thence North through $W \frac{1}{2}$ Sec 30
- 20 00 Set Temporary $\frac{1}{16}$ corner
- 39 62 The center $W \frac{1}{2}$ Sec 30 a Post.
- from which
- a Hawthorn 4 inch dia $S 2^{\circ} W$ 12 lks dist
- Thence North through $NW \frac{1}{4}$ Sec 30
- 20 00 Set Temporary $\frac{1}{16}$ corner
- 41 00 The $\frac{1}{8}$ corner on North boundary $NW \frac{1}{4}$ Sec 30
- Thence South through $NW \frac{1}{4}$
- 20 50 Set Stone 5 + 13 + 24 for $\frac{1}{16}$ corner in center $NW \frac{1}{4}$
- 41 00 center West $\frac{1}{2}$ Sec 30

J. W. Kimbrell County Surveyor