


RECORD OF SURVEY
No. 113

Township 6 South Range 38 East W.M. Union County, Oregon.

John O. Bryant May 30 1890

CHAINS
LINKS

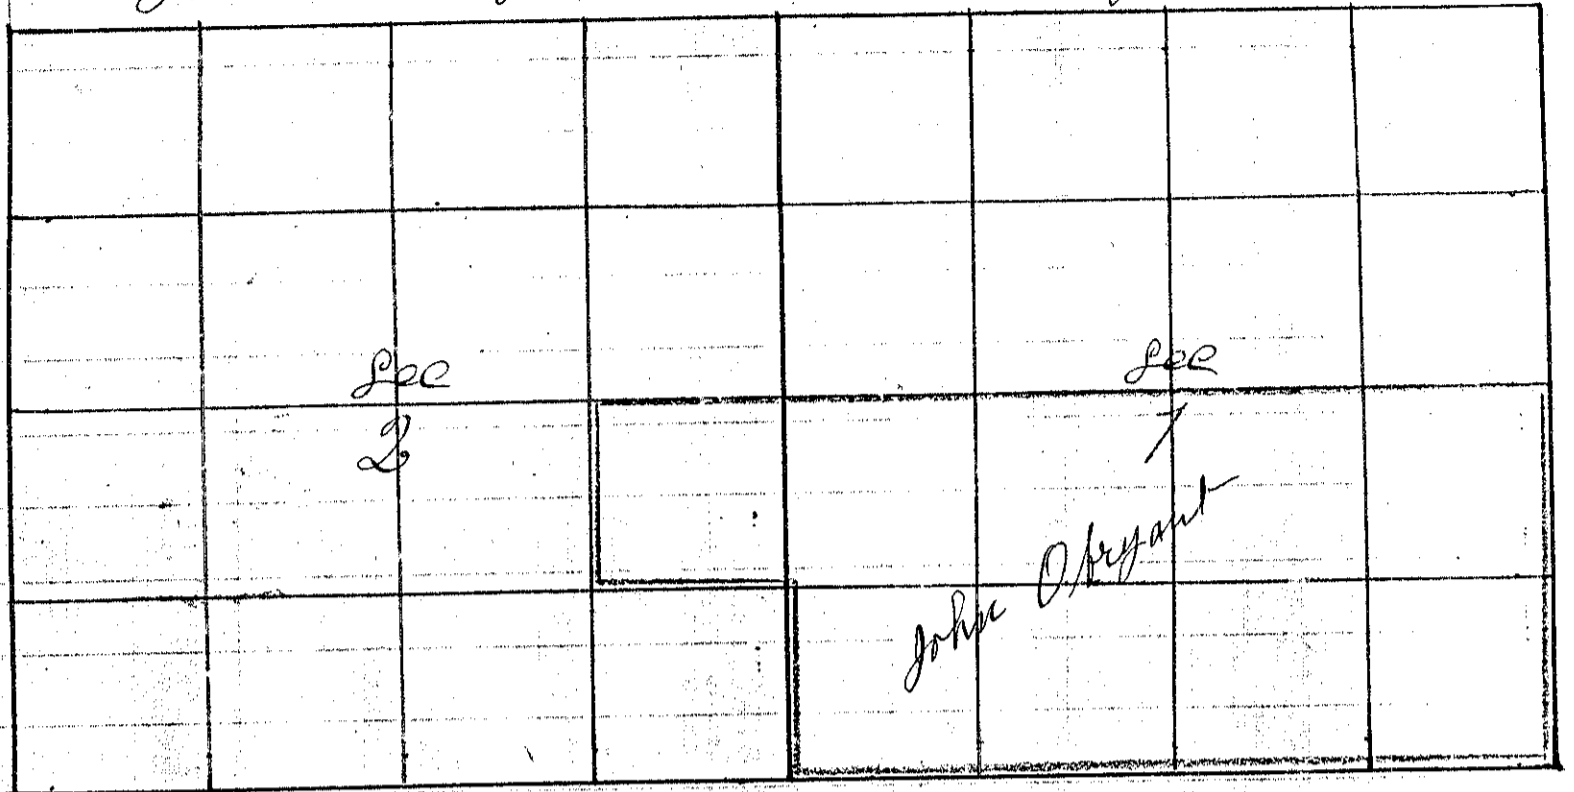

I Commenced at the corner to See 1-12-6 & 7
Thence North bet See 1 & 6
var 20° E

40 06 The 1/4 See corner bet See 1 & 6
Thence west through See 1
var 29° E

20 00 Set temporary 1/16 corner
40 00 Set temporary center See 1
60 00 Set temporary 1/16 corner
81 35 Intersect 53 lks North of 1/16 See corner bet See 1 & 2
Thence N 89° 37' E on line line

The 1/4 See corner bet See 1 & 2
Thence S 3 1/2° E bet See 1 & 2
var 20° E

20 00 Set temporary 1/16 corner
40 06 Intersect 16 lks East of corner to See 1-2-11 & 12
Thence N 14° E on line line

20 03 Set Post for 1/16 corner
Thence west

20 00 Set Post
Thence North

20 03 Set Post
Thence East

20 00 The 1/4 See corner bet See 1 & 2

J. M. Kimball County Surveyor