


Township 4 & 5 South Range 39 East W.M., Union County, Oregon.

P. M. Coffin

June the 4 1890

CHAINS. LKS.

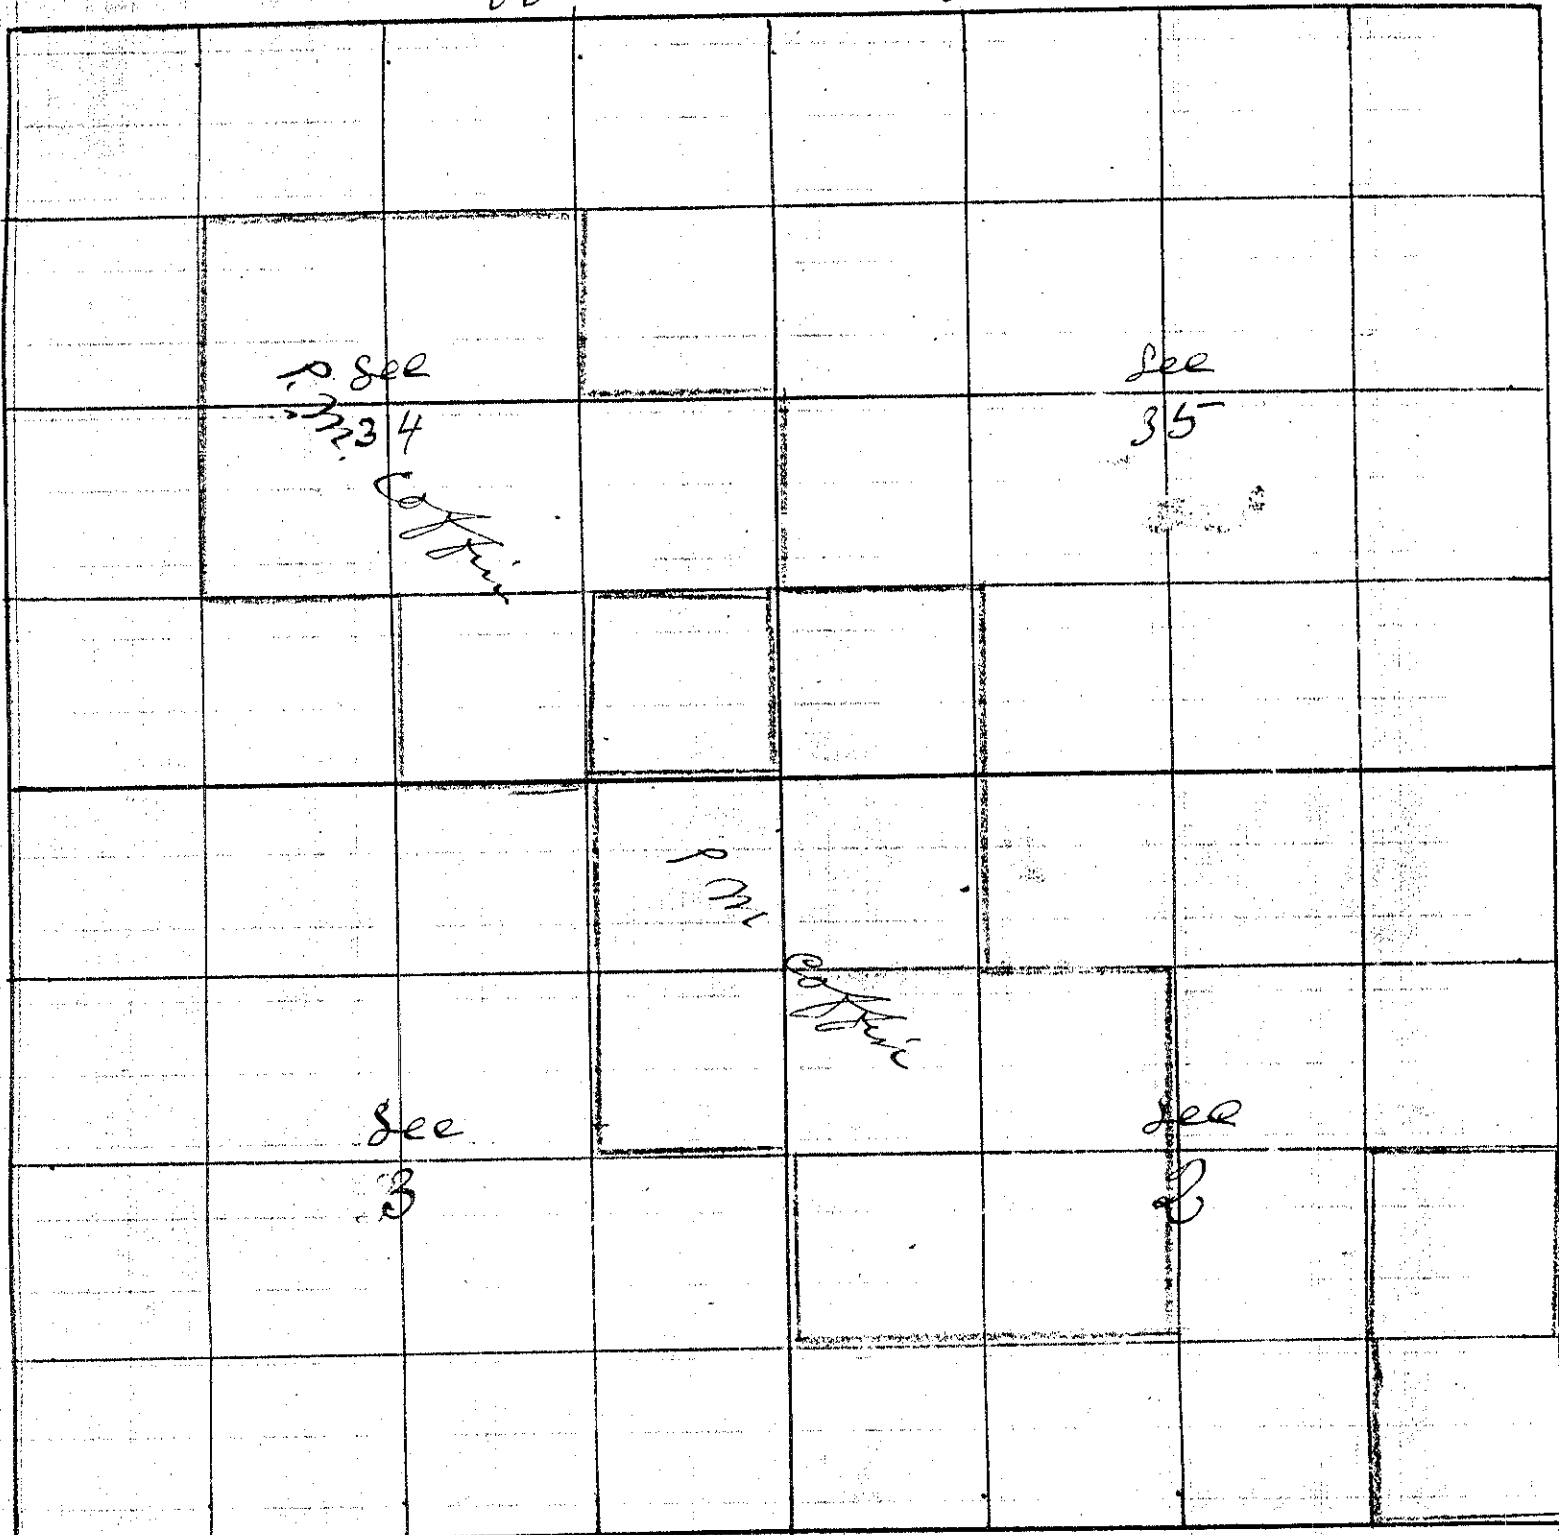

I Commenced at the corner to Sec 2-3-34 & 35
 on Township line bet 4 & 5 South
 which is a Post in mound of Stone
 Thence South bet Sec 2 & 3
 var 20° E

- 19 80 Set Temporary 1/8 corner
- 40 07 Intersect 8 lks East of 1/4 Sec corner bet Sec 2 & 3
 Thence N 7° E on Towne line
- 20 14 Set Post for 1/8 corner
- 40 07 The corner to Sec 2-3-34 & 35 -

The 1/4 Sec corner bet Sec 2 & 3
 Thence S 7° W bet Sec 2 & 3 var 20° S

- 20 00 Set Temporary 1/8 corner
- 40 00 Intersect 92 lks west of corner to Sec 2-3-10 & 11
 Thence N 7° 19' W on Towne line bet Sec 2 & 3
- 20 00 Set Post in mound of Stone for 1/8 corner
- 40 00 The 1/4 Sec corner bet Sec 2 & 3

Township 4 & 5 South

Range 39 East

Union County, Oregon.

CHAINS. LKS.

The 1/4 Sec corner bet Sec 2 & 3

Hence East through Sec 2

var 20° 7' E.

40 00 Set Temporary center Sec 2 on top of Ridge NW 1/4 S E

60 00 Set Temporary 1/6 corner

71 28 Intersect 85 lks south of 1/4 Sec corner bet Sec 1 & 2

Hence S 89° 23' W on same line through Sec 2

The 1/4 Sec corner bet Sec 2 & 35-

Hence South through Sec 2

var 20° E

20 00 Set Temporary 1/6 corner

39 85 Intersect True E & W line 85 lks west of 1st Stake at center

59 85 Set Temporary 1/6 corner

80 22 Intersect 293 lks west of the 1/4 Sec corner bet Sec 2 & 31

Hence N 2° 6' W on same line through Sec 2

20 13 1/2 Set Stone in mound of Stone for 1/6 corner in center S 1/2 Sec 2

40 27 Set Stone in mound of Stone for center Sec 2 on top of Ridge S 25° E N 25° W

60 27 Set Stone in mound of Stone for 1/6 corner in center N 1/2 Sec 2

80 22 The 1/4 Sec corner bet Sec 2 & 35 -

The center Sec 2 Hence East

20 33 1/2 Set Post in mound of Stone for 1/6 corner in center E 1/2 Sec 2

40 67 The 1/4 Sec corner bet Sec 1 & 2

Hence South bet Sec 1 & 2

var 20° E

20 00 Set Temporary 1/8 corner

40 45 Intersect the corner of Sec 1 = 2 = 11 1/2

Hence north bet Sec 1 & 2

20 22 1/2 Set Stone in mound of Stone for 1/8 corner

40 45 The 1/4 Sec corner bet Sec 1 & 2

The corner of Sec 1 = 2 = 11 1/2

Hence south bet Sec 11 1/2

var 20° E

20 00 Set Temporary 1/8 corner

40 20 Intersect 50 lks west of 1/4 Sec corner bet Sec 11 1/2

Hence N 43° W on same line bet Sec 11 1/2

20 10 Set Stone in mound of Stone for 1/8 corner

40 20 The corner of Sec 1 = 2 = 11 1/2

Hence East bet Sec 1 & 2 var 20° E

20 00 Set Stone in mound of Stone

Township 4 & 5 South Range 39 East Union County, Oregon.

CHAINS.	LINKS.	
		The corner to Sec 2=3=34 & 35 - Thence East on Tp line to Sec 1 & 34 var 20° E
20	00	Set Temporary 1/8 corner
40	24	Intersect 24 lks North of 1/4 Sec corner to Sec 2 & 35 - Thence N 89° 38' W on Town line
20	12	Set Stone in Mound of Stone for 1/8 corner
40	24	The corner to Sec 2=3=34 & 35 -
		The 1/8 corner on West Boundary N W 1/4 Sec 2 Thence East through N W 1/4 Sec 2 var 20° E
20	00	Set Temporary 1/16 corner
40	44	Intersect 1/16 corner in center N 1/2 Sec 2 Thence West through N W 1/4
20	22	Set Post for 1/16 corners in center N W 1/4 Sec 2
		The 1/4 Sec corner to Sec 2 & 11 Thence East to Sec 2 & 11 var 20° 30' E
20	00	Set Temporary 1/8 corner
37	50	Intersect corner to Sec 1=2=11 & 12 Thence West to Sec 2 & 11
18	75	Set Stone in Mound of Stone for 1/8 corner
37	50	The 1/4 Sec corner to Sec 2 & 11
		The corner to Sec 2=3=34 & 35 - Thence North to Sec 34 & 35 - var 20° E
20	00	Set Temporary 1/8 corner
41	05	Intersect 105 lks West of 1/4 Sec corner to Sec 34 & 35 - Thence S 1° 30' W on Town line
20	52 1/2	Set Stone in Mound of Stone for 1/8 corner
41	05	The corner to Sec 2=3=34 & 35 -
		The 1/8 corner on South Boundary S W 1/4 Sec 35 - Thence North through S W 1/4 Sec 35 -
20	00	Set Stone in Mound of Stone for center S W 1/4 Thence West through W 1/2 S W 1/4
20	00	The 1/8 corner on West Boundary S E 1/4 Sec 35 -

Township 4 & 5 South Range 39 East Union County, Oregon.

CHAINS.	LR.	
		The 1/4 Sec corner bet Sec 34 & 35 - Thence west through Sec 34 Var 20° E
40	00	Set Temporary center Sec 34
00	25	Set Temporary 1/16 corner -
82	75	Intersect 1/4 Sec corner bet Sec 33 & 34
		The 1/4 Sec corner bet Sec 3 & 34 Thence North through Sec 34 Var 20° E
20	00	Set Temporary 1/16 corner
40	45	Intersect ^{1/2} E & W line 165 lks west of 1st Stake at Center
79	77	Intersect - 114 lks East of the 1/4 Sec corner bet Sec 28 & 34 Thence S 49° E on True line through Sec 34
38	82	Set Post in Mound of Stone for Center Sec 34
60	14	Set Post in Mound of Stone for 1/16 corner in center S 1/2 Sec 34
77	77	The 1/4 Sec corner bet Sec 3 & 34 The 1/4 Sec corner bet Sec 33 & 34 Thence East on True line through Sec 34
20	46	Set Stone in Mound of Stone for 1/16 corner in center W 1/2 Sec 34
40	52	Center Sec 34 a Post in Mound of Stone
82	75	The 1/4 Sec corner bet Sec 34 & 35 -

The 1/4 Sec corner bet Sec 2 & 3
Thence west through E 1/2 Sec 3

20 00 Set Stone in Mound of Stone

J. W. Winfield County Surveyor