


RECORD OF SURVEY

No 116

Township 2 South Range 40 East W.M. Union County, Oregon.

Oliver Perine C.W. Hamilton & Marion Johnson June 20th 1890

CHAINS. LKS.

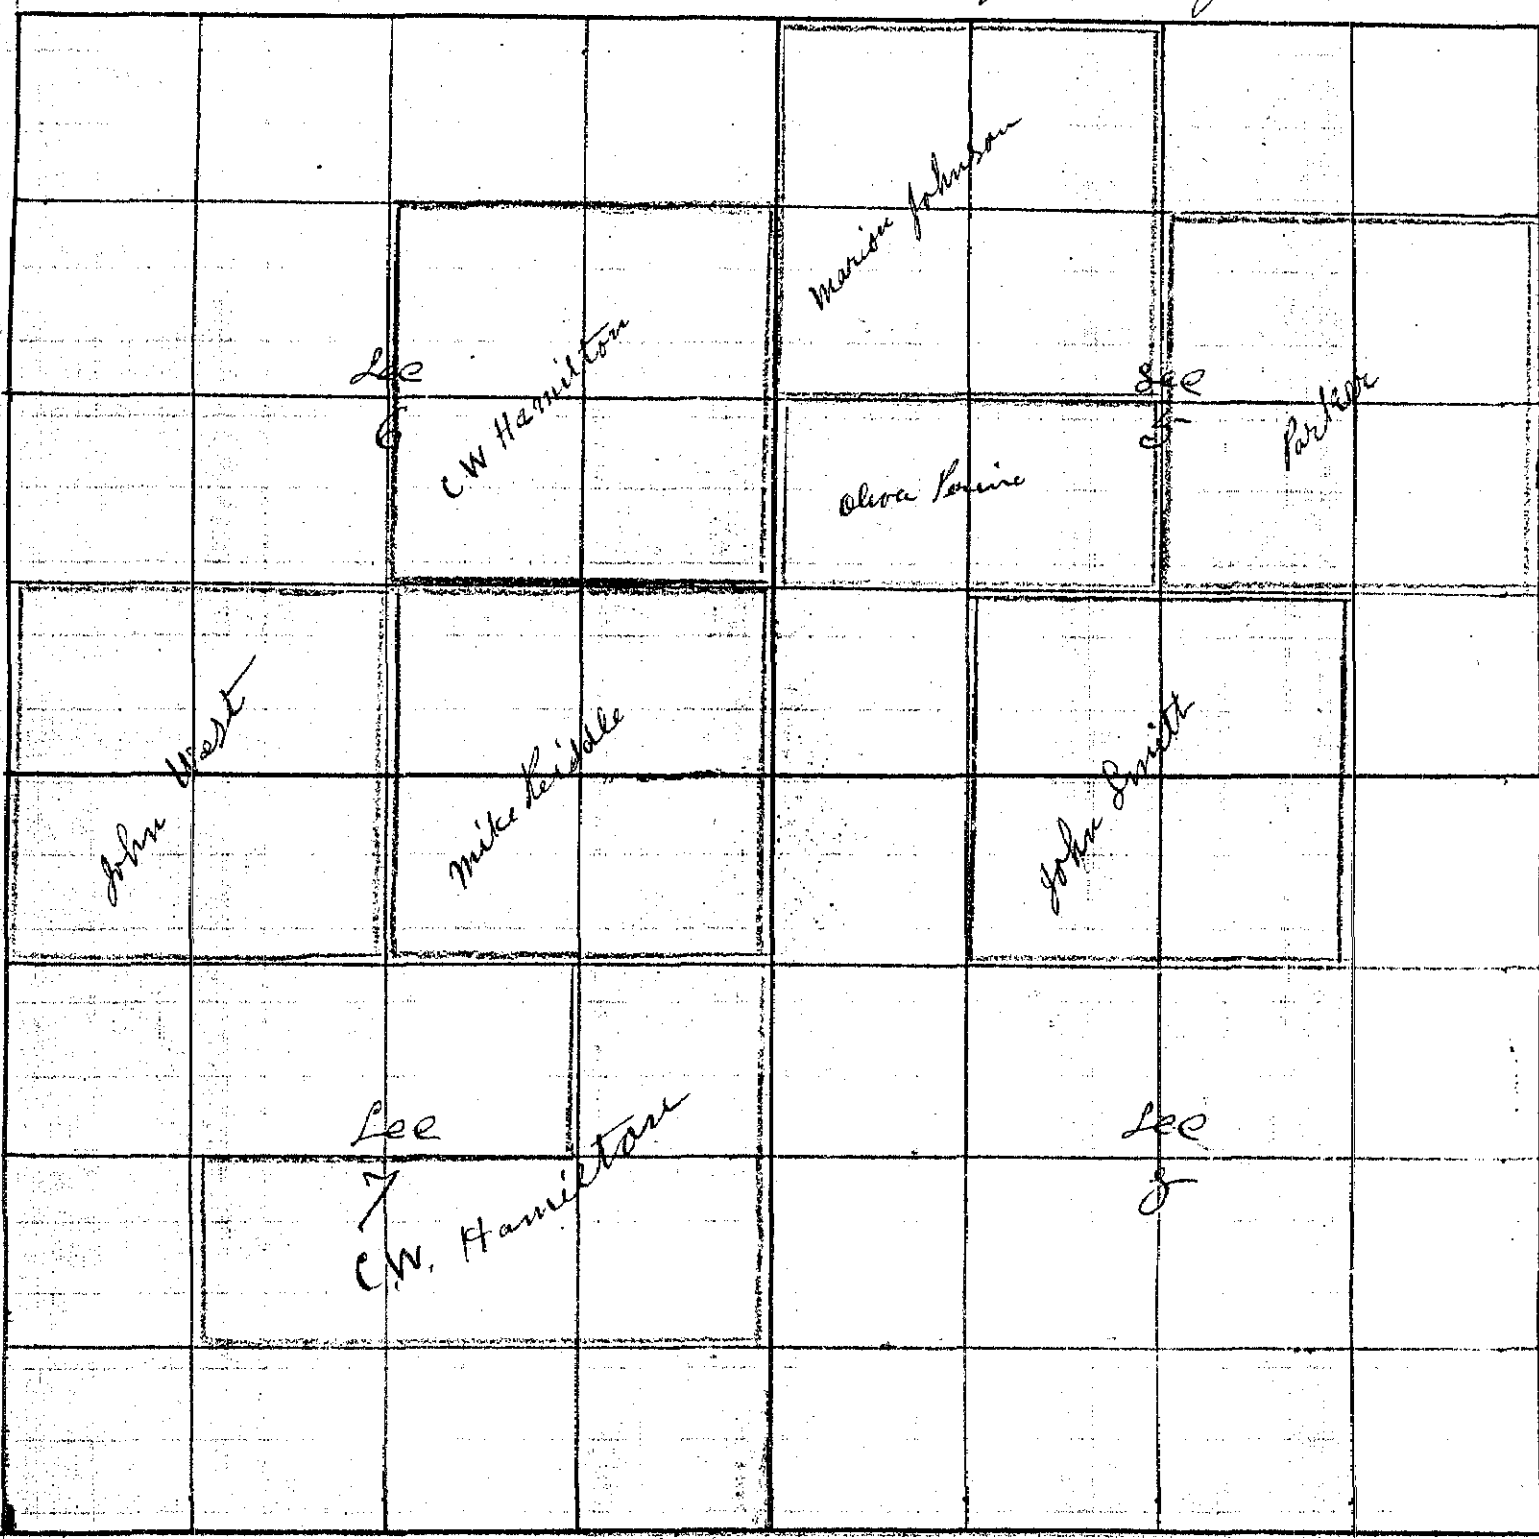

I Commenced at the 1/4 Sec corner bet Sec 5 & 6
Thence East through Sec 5
Var 20° E

- 15 00 Var 28° E
- 18 00 Var 22 3/4° E
- 20 00 Set Temporary 1/16 corner Var 22° E
- 24 00 Var 19 1/4° E
- 25 50 Var 17 1/4° E
- 30 30 Top of Hill
- 31 00 Descend very steep East Side of Hill
- 40 00 Set Temporary center Sec 5
- 80 40 Intersect .55 lks South of 1/4 Sec corner bet Sec 4 & 5
Thence S 89° 37' W on True line through Sec 5
- 40 57 center Sec 5
- 60 48 center 1/2 Sec 5
- 80 40 The 1/4 Sec corner bet Sec 5 & 6

RECORD OF SURVEY

Township 2 South Range 40 East Union County, Oregon.

CHAINS. L.SS.

The 1/4 Sec corner bet Sec 7 & 8
Thence South bet Sec 7 & 8
Var 29° E

- 7 00 Var 23 1/2° E
- 12 00 County Road Course E 1/4 W
- 15 91 Top of Cliff
- 20 00 Set Temporary 1/8 corner
- 24 00 Ravine course S W
- 39 11 Intersect 170 lks west of the corner to Sec 7 = 8 = 17 3/8
Thence N 2° 26' W on True line
- 19 55 1/2 Set Stone in mound of Stone for 1/8 corner
on S E Slope of Steep Hillside

The corner to Sec 6 = 7 = 1 of 12
on Guide Meridian bet Ranges 39 of 40 East
from which

- a Pine 18 inch dia. frs S 72° W 105 lks dist
- " 16 " " " S 55° E 75 " "
- Spruce 14 " " " N 28° E 65 " "
- " 8 " " " N 47° W 109 " "

Thence North on Guide Meridian bet Sec 1 & 6

- 20 00 Set Temporary 1/8 corner Var 21° 15' E
- 40 30 Intersect 38 lks west of 1/4 Sec corner bet Sec 1 & 6
from which
- a Pine 24 inch dia frs S 83° E 236 lks dist
- " 16 " " " N 68° W 246 " "
- Thence S 33° W on True line

- 20 15 Set Post for 1/8 corner
- 40 30 The corner to Sec 6 = 7 = 1 of 12

J. W. Kimball County Surveyor