

No 117

Township 2 South


Range 40 East W M

Union County, Oregon.

Wm. B. Boothe

June the 25th 1890

I Commenced at the corner
of Sec 20=21=28 & 29
a Stone 10x11x23
Thence East bet Sec 21 & 28
Var 20° 15' E

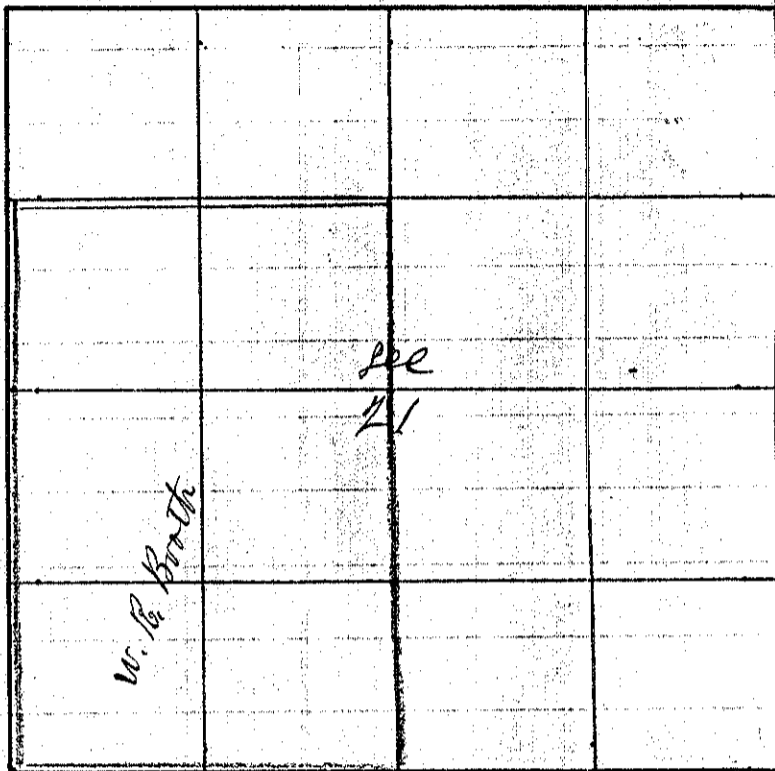

- 18 50 Spring Branch course SW
- 20 00 Set temporary 1/8 corner
- 40 00 Set temporary 1/4 Sec corner
- 80 68 Intersect 18 lks South of the corner of Sec 21=22=27 & 28

Thence S 89° 52' W on same line

- 40 34 Set Post in mound of Stone for 1/4 Sec corner bet Sec 21 & 28
- 60 51 Set Post for 1/8 corner
- 80 08 The corner of Sec 20=21=28 & 29

J. W. Kimbrell County Surveyor