


Township 1 South Range 39 East Union County, Oregon.

CHAINS. LKS.

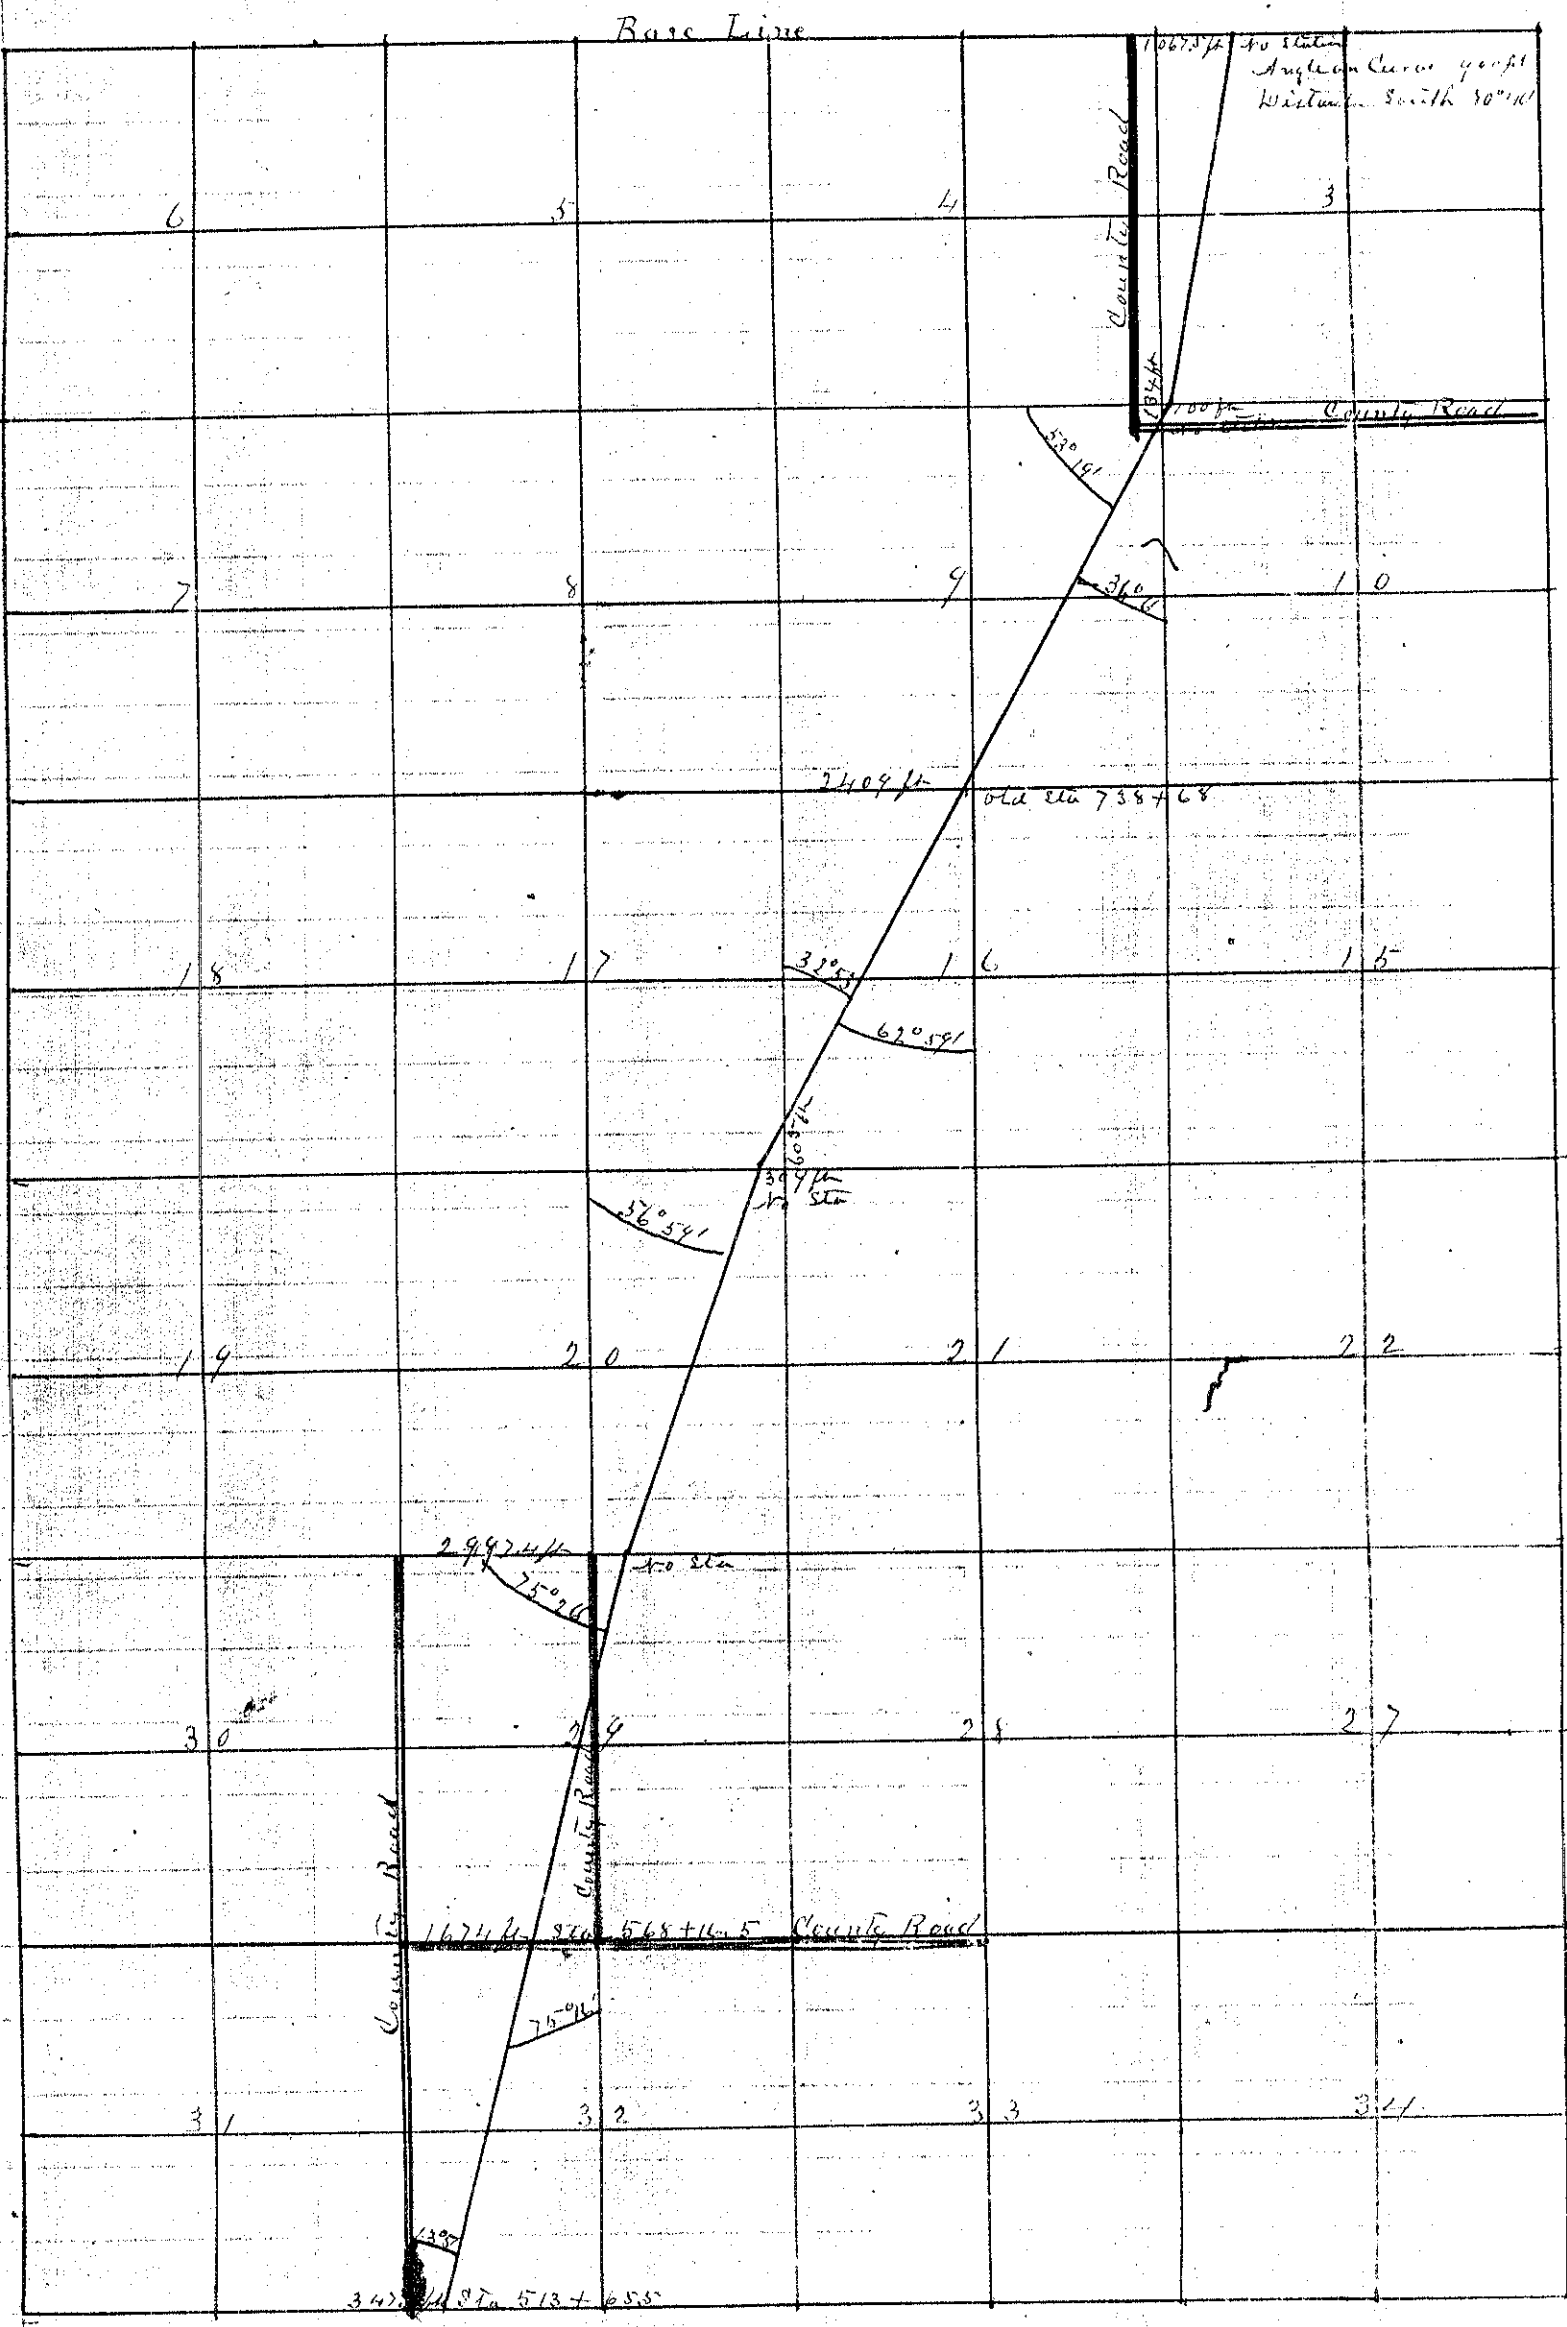

SW Corner Sec 32	Distance East to R.R.	347.3 ft	Connect at Sta	513+65.5	Angle	139°
NW "	"	1674 "	"	568+16.5	"	75° 11'
NW "	"	2997.4 "	"	"	"	75° 02'
S' 210°	"	16 "	West "	309 "	"	38° 2'
"	"	"	North "	605 "	"	32° 1'
NW "	"	"	East "	2409 "	"	62° 1'
Sh R	"	9 "	"	100 "	"	53° 19'
"	"	"	South "	134 "	"	36°
Station	"	3 "	Station "	1067 "	"	Angle in Curv