RECORD OF SURVEY

263
1890

Township 1 North Range 34 East Union County, Oregon.

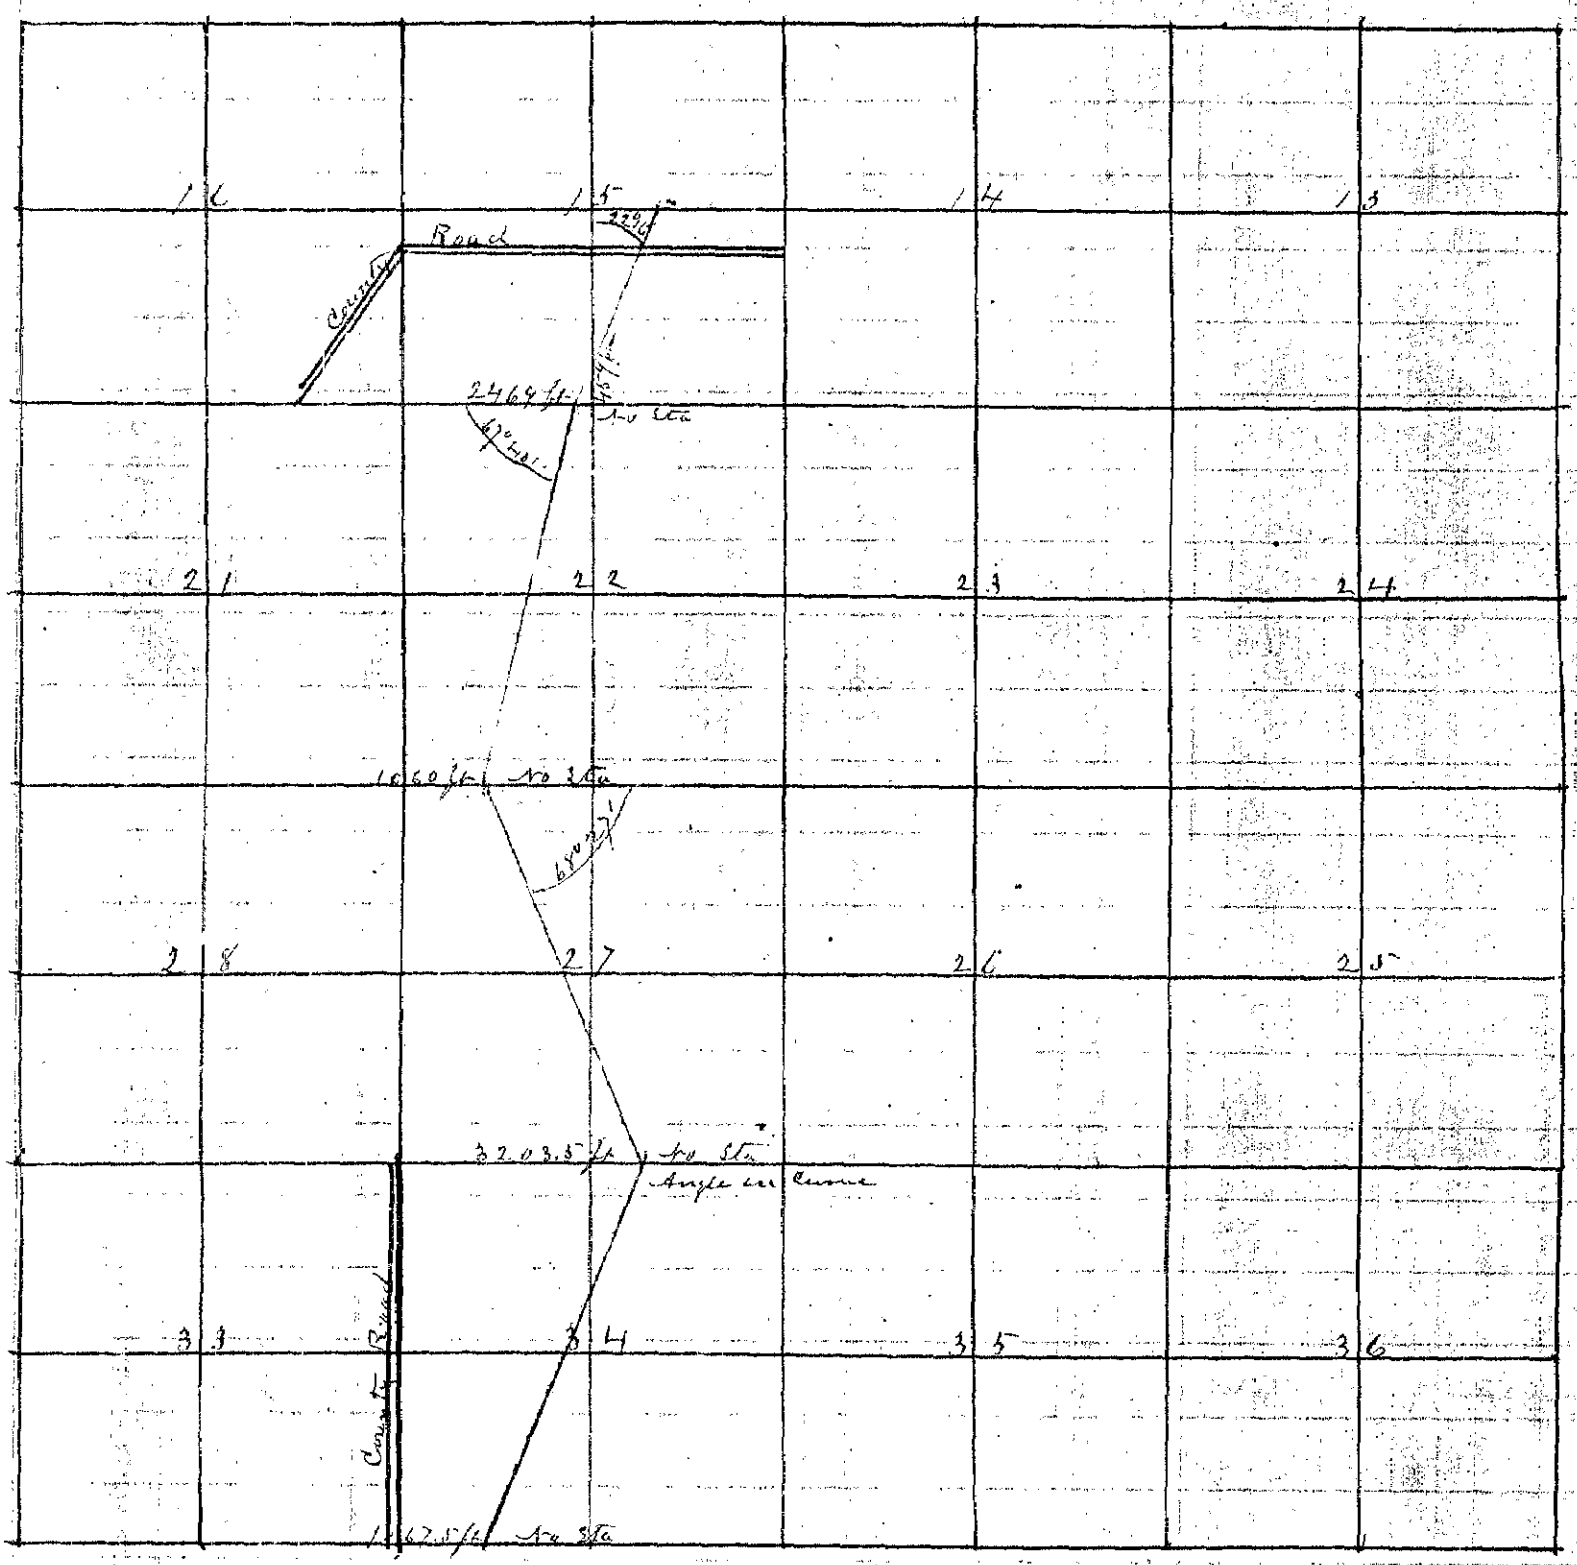

S W Corner Sec 34 Distance East to RR 1067.5 ft Corner at Sta ____ Angle on Corner

N 10 " " " " " " " 3203.5 " " " "

N W " " 27 " " " 1060 " " " 68° 27'

N W " " 22 " " " 2469 " " " 67° 40'

1/4 Sec Between 15 and 22 " North " 459 " " " 22° 16'

J L Curtis
County Surveyor