

# RECORD OF SURVEY


277

1891

T<sup>o</sup> 132

Township 2 South Range 39 East Union County, Oregon.

A Gungloff June 9<sup>th</sup> A 10 1891  
Var 20° E

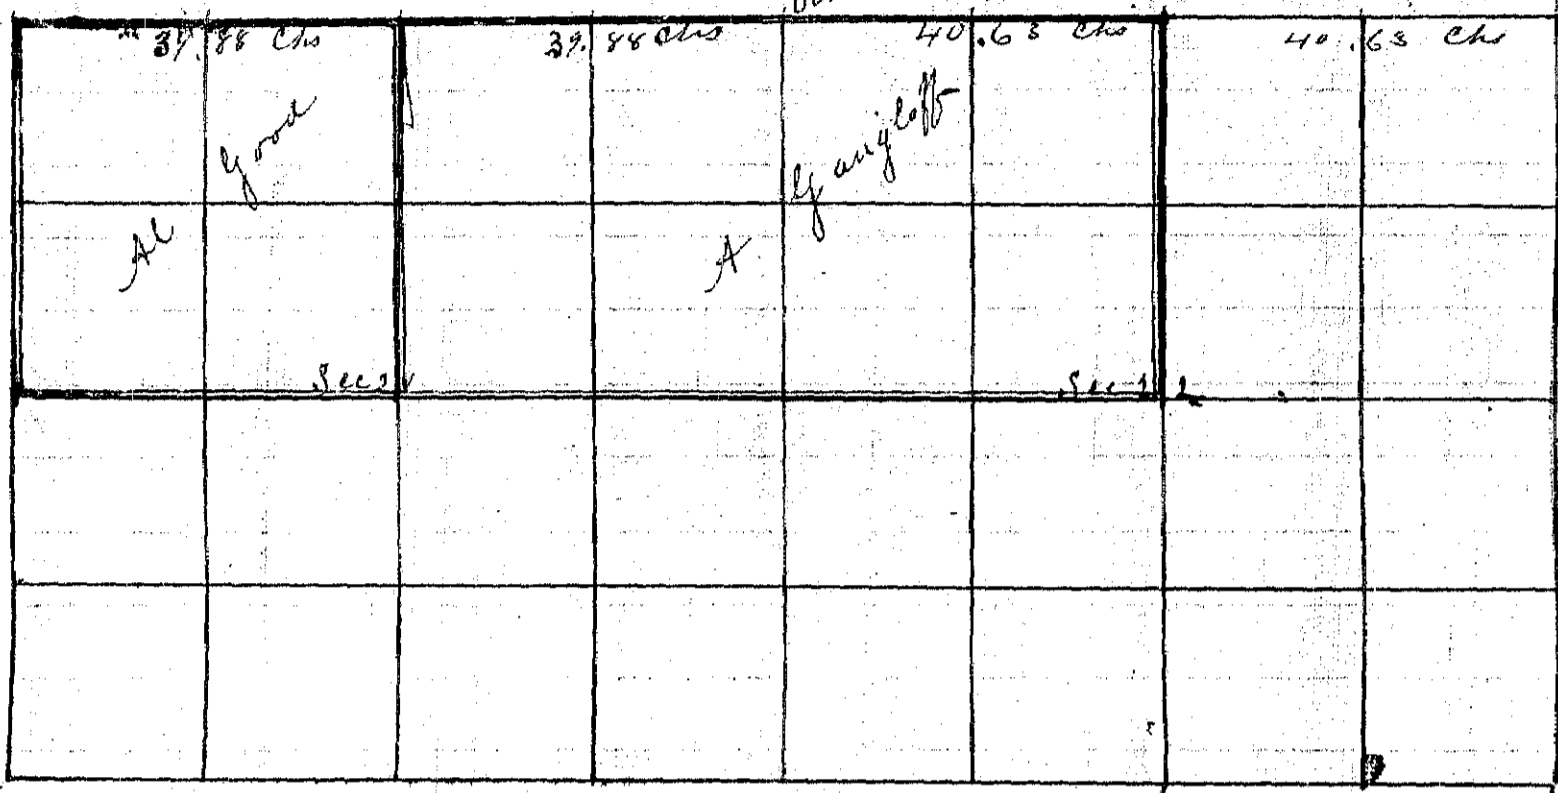

This survey was made June 9<sup>th</sup> A 10 1891 commencing at the N E corner of Sec 22 T. S. R. 39 East and running thence West Var 20° 30' East

40 00 Chs set temporary 1/4 Sec corner thence W same direction  
 41 26 ~ intersected corner between Secs 15, 16, 21, 22

Thence East on true line

40 63 Chs set 1/4 Sec corner between Sections 15 and 21 A Rock containing 17 28 solid inches marked 1/4 S

From the N E corner of Sec 21 West Var 20° E

40 00 Chs set temporary corner thence W same direction  
 39 76 ~ intersected Sec corner between Secs 16, 17, 20, 21

Thence East on true line

39 88 Chs set 1/4 corner between Secs 16 and 21 A Rock containing 17 28 solid inches marked 1/4 S

J. L. Coates  
 County Surveyor