


RECORD OF SURVEY

No 133


Township 2 N Range 41.0 East Union County, Oregon.

CHAINS. LBS.

N Larson and A J Wood

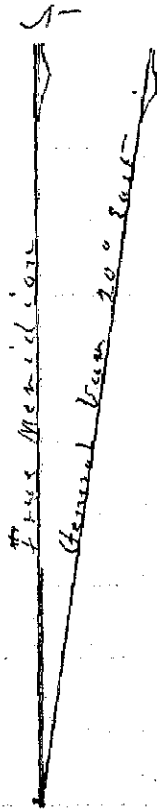

Scale 4 in To The Mile

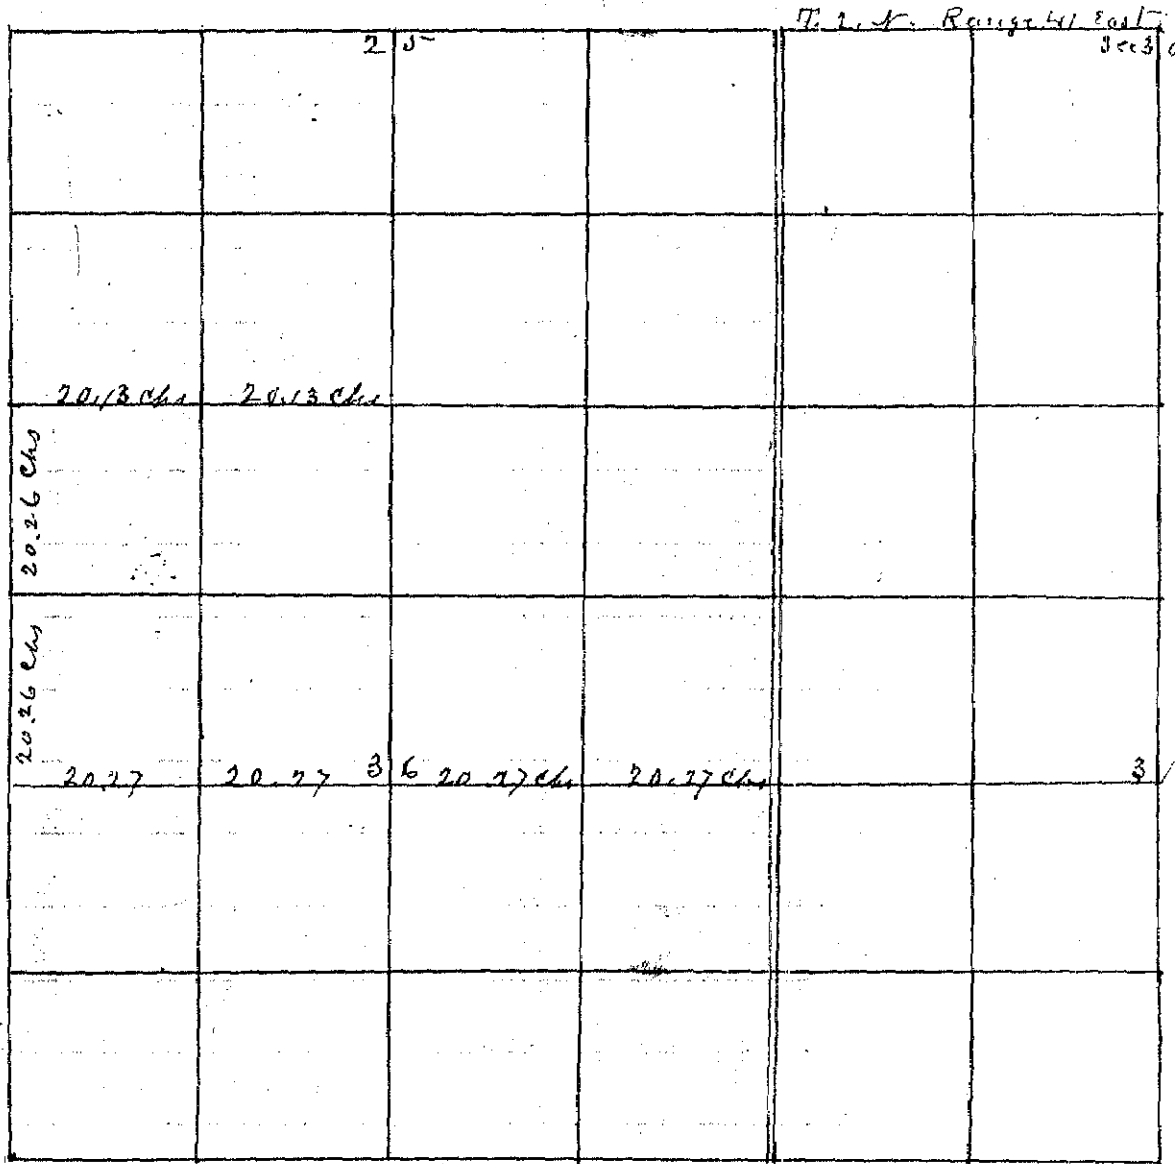

This survey was made June 15th 1891 for the purpose of establishing the line between N Larson and A J Woods and also the center of Sec 36.

The corners being all known I measured from the 1/4 Sec corner between Sec's 35 and 36 and found the distance to be

40 52 I then chained from the 1/4 Sec corner between Sec 25 and 26 and found the distance to be

40 26 I then chained from the 1/4 Sec corner between Sec 31, T. 2. N. Range 41 and Sec 36, T. 2. N. Range 40 to the 1/4 Sec corner between Sec's 35 and 36 T. 2. N. R. 40 and found the distance to be

81 08 From three measurements I established the center of Sec 36 and the N E and S E corners to the S W 1/4 of the N W 1/4 of Sec 36 on a general bearing of 20° E and marked all the said points with Rocks according to law

J L Curtis
Surveyor