
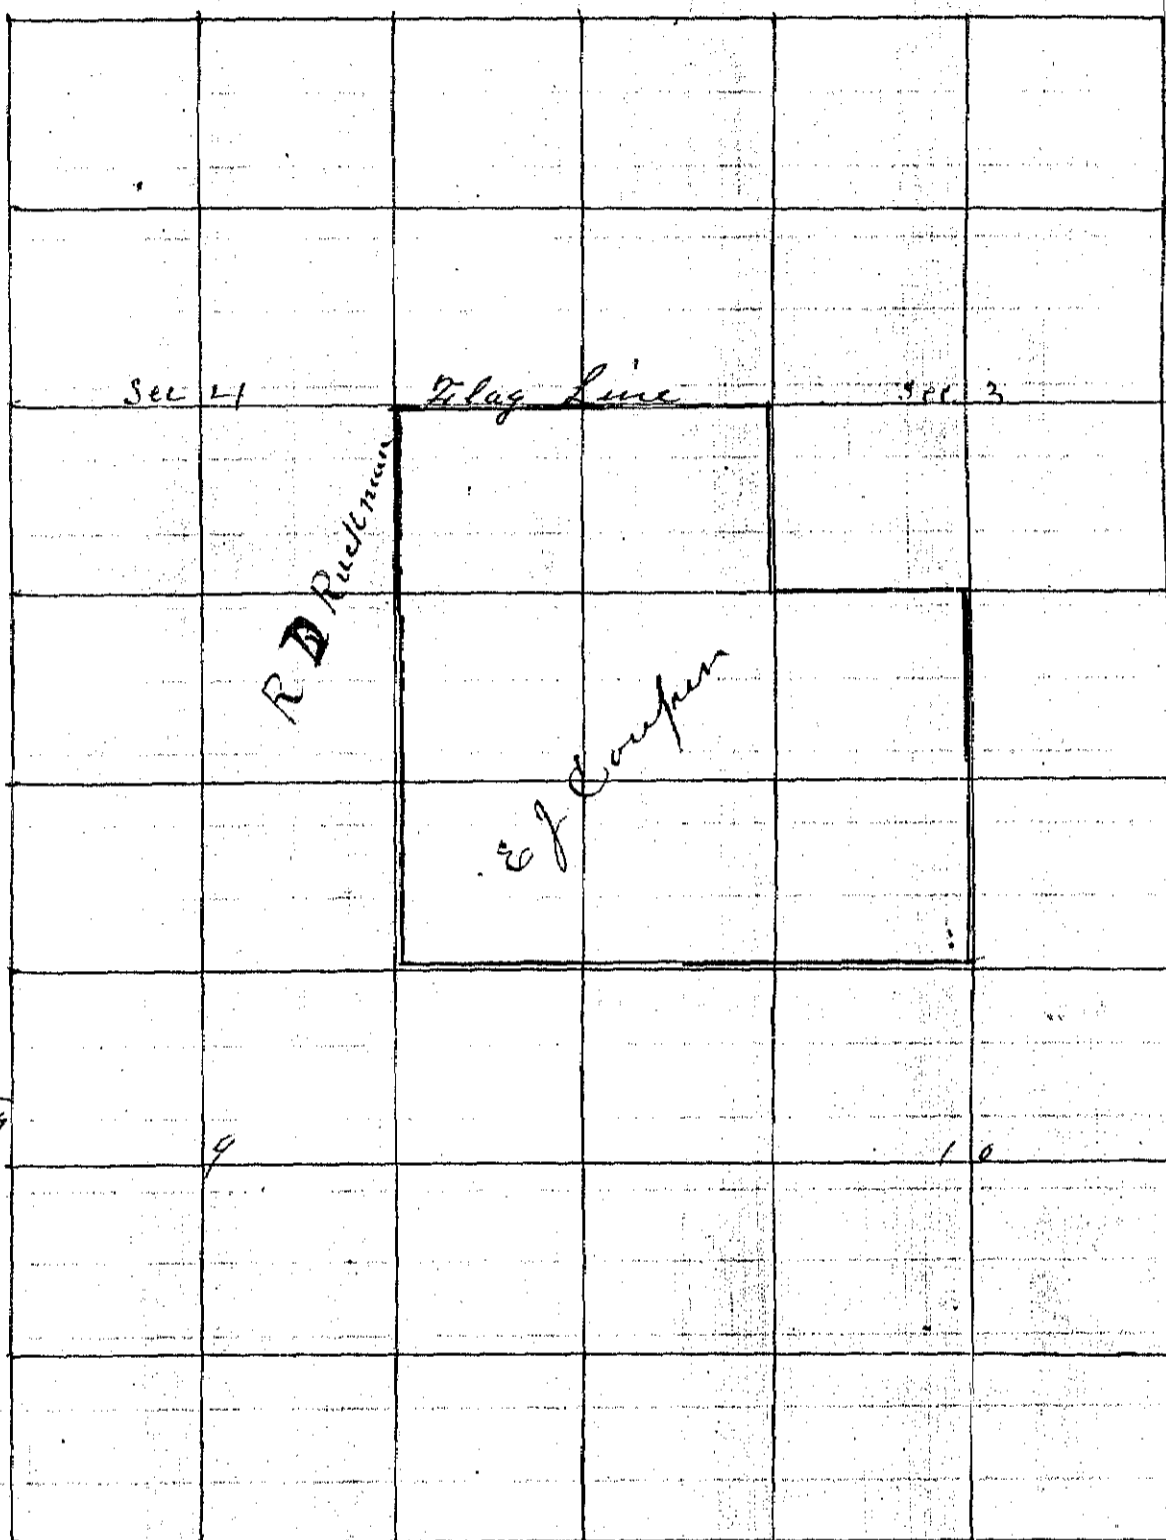


No 134

Township 2 South Range 39 East Union County, Oregon.

E J Cooper and R D Ruckman

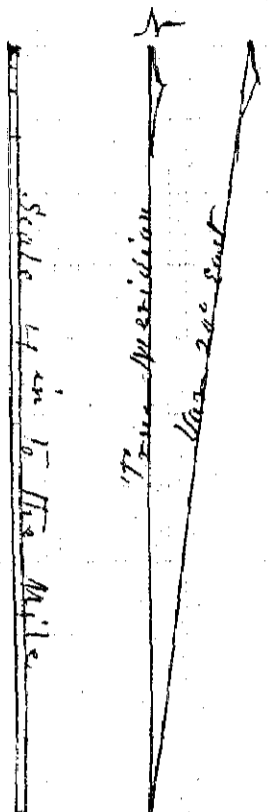

This survey was made
 on June 17th 1891
 I commenced by setting
 a flag at the 1/4 sec
 corner between sec's 2
 and 3
 I then chained from
 N E corner of Sec 6
 South Var 20° E

39 50 Thence E on a straight line to the flag without chaining
 until I intersected the 1/4 sec corner between Secs 3 and 4
 From thence I chained W on the true line
 20 and set corner to the NW corner of NE 1/4 of SE 1/4 of
 Sec 4
 60 20 Thence S on a Var of 20° E
 Intersected SW corner of the NE 1/4 of NE 1/4 sec 9

J L Curtis
 Surveyor