


N<sup>o</sup> 160

Township 3 S Range 38 East Union County, Oregon.

For W & Peach et al Original Cemetery

NW corner of S16<sup>4</sup>  
of S84 sec 3  
T.3.S. R. 38.E

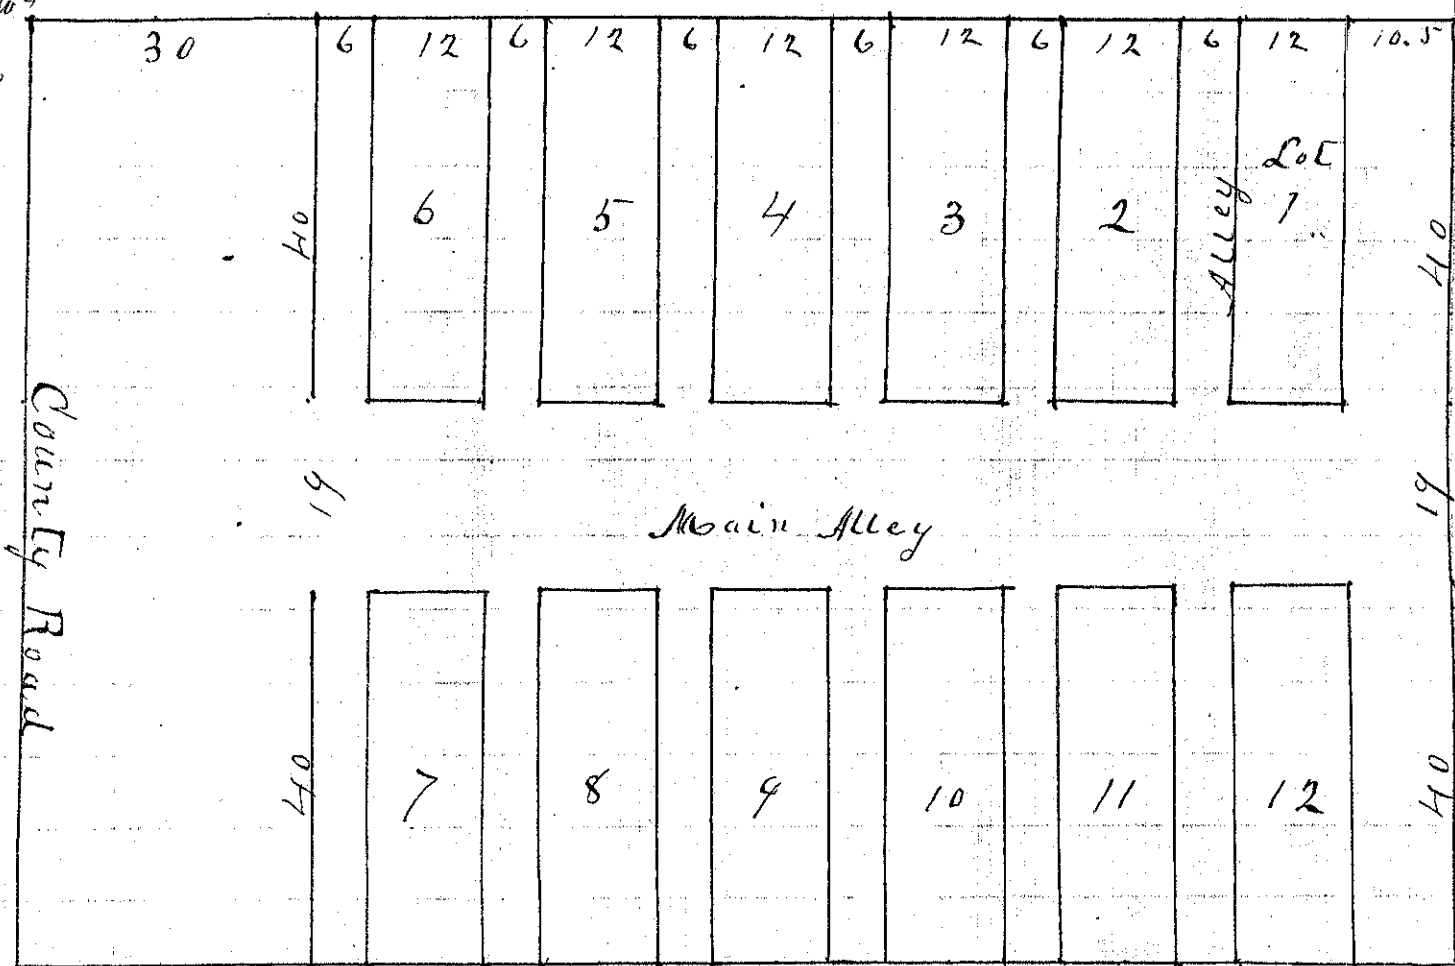

Scale 20 ft To 1 inch

The survey of this Land for Cemetery purposes was made at the request of W & Peach on March 15<sup>th</sup> 1892 as follows to wit  
 Commencing at a point 1320 ft North of the 1/4 section corner between Sections 3 and 10 in Township 3. S. R. 38 East and running thence East 148.5 ft thence South 99 ft thence West 148.5 ft thence North 99 ft to the place of Beginning and containing 5.4 square Rods of ground.

J L Curtis  
 County Surveyor

The Peach Addition to this Cemetery is recorded on Folio 307