

RECORD OF SURVEY

291
1892


No 166

Township 3 South Range 37 East Union County, Oregon.

L.R.S.

For Len Parish

Date May 13th 1892

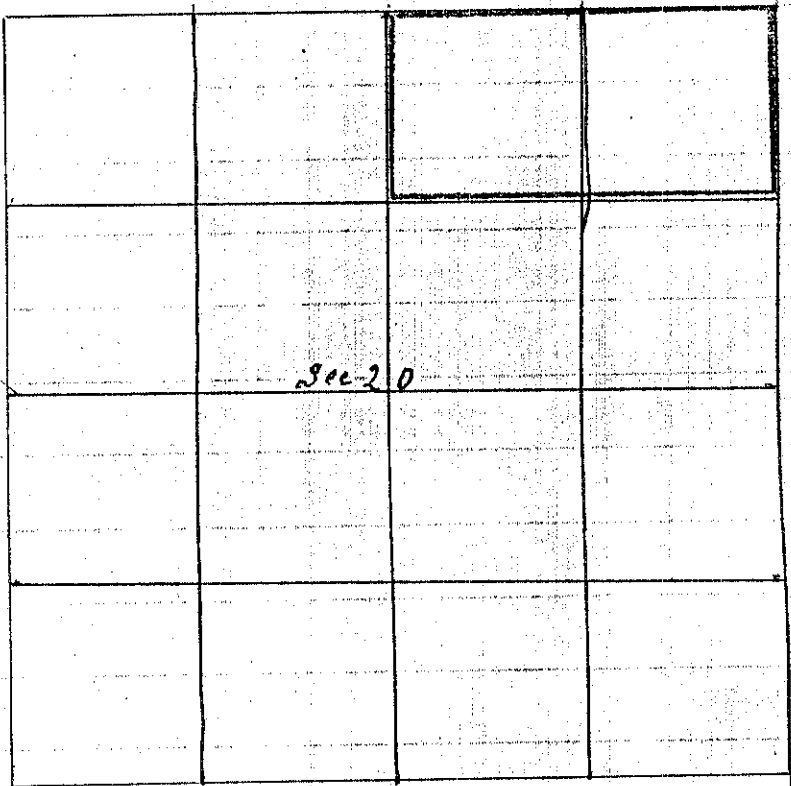

Commenced at the Sec Corner between Secs 16-17-20 & 21 thence West Var 21° 30' E

41 05 Intersected 1/4 corner between Sec 17 & 20

From corner to 16-17-20 & 21 South on random line Var 21°

82 06 Intersected corner to Sec 20-21-28 & 29. 2.05 chs East of the corner thence North on true line N 1° 30' W

61 5 1/2 Set Rock 18-12-6 for corner to SE corner of T 5th of T 5th Sec 20 thence West Var 21° E

41 05 Set temporary corner

From the 1/4 corner between Secs 17 & 20 South

20 5 1/2 Intersected SW corner of NW 1/4 of T 5th Sec 20 Set Rock 8-10-16 for centre of T 5th of Sec 20 S. 3. S. R. 37 East

J L Curtis
County Surveyor