
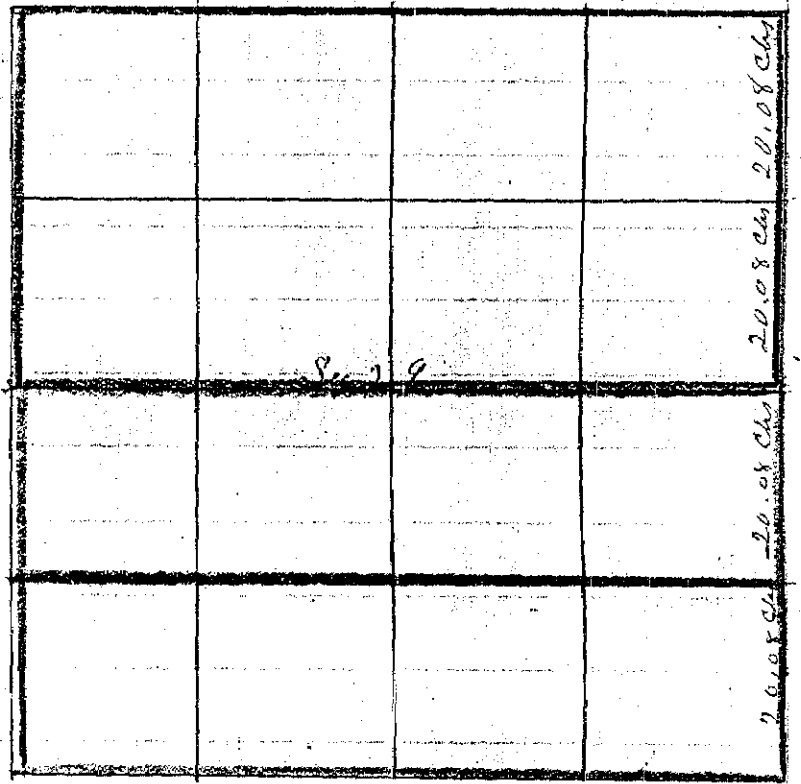


N<sup>o</sup> 167

Township 2 South Range 40 East Union County, Oregon.

CHAINS  
Lks.

That Brasher et al Done June 27<sup>th</sup> 1892

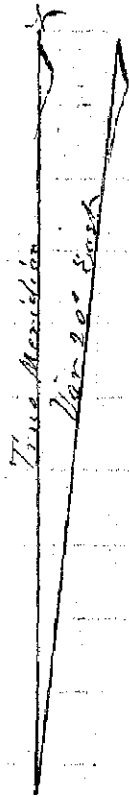

This survey was made June 27<sup>th</sup> 1892 for the purpose of establishing a division line between Tom Brasher and Corbin on the South half of Sec 29. Township 2 South Range 40 East. I chained from the corner to Sec's 20-21-28 & 29 south to the corner to Sec's 28-29-32 & 33 and found an excess of 31.5 lks. This I have divided between Brasher Corbin and Smith and find that Smith's division line is 2 1/4 links on Brasher's Land and that the fence between Brasher and Corbin is 2.5 links on Brasher's Land.

J. L. Curtis  
County Surveyor