


RECORD OF SURVEY

No 173

Township 2 South Range 37 East Union County, Oregon.

77 16 Remington on W J Mudgrass Land Jan 24th 1893

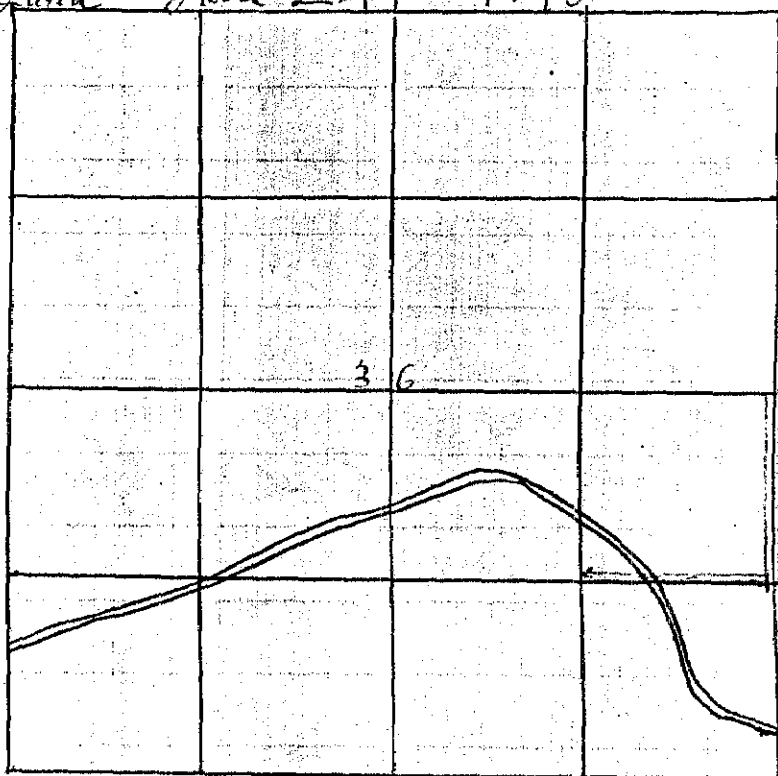

Commenced at the $\frac{1}{4}$ Sec corner on the East Boundary line of Sec 36 T. 2. South Range 37 East Will Mer and from thence South var 19° East

20.00 intersect $\frac{1}{8}$ corner as established by some person unknown from thence West var 19° East

20.00 to the SW corner of $\frac{1}{4}$ of 32° Sec 36 T. 2. S. R. 37 East Set Rock 8+12+16 marked $\frac{1}{16}$ in mound of Rock from which A Pine Tree 6 inches in diam marked $\frac{1}{16}$ bears S. 80° East 44 lks Distant

J. L. Curtis
County Surveyor