


# RECORD OF SURVEY

No. 181

309  
1895

Township 4 S Range 39 E Union County, Oregon.

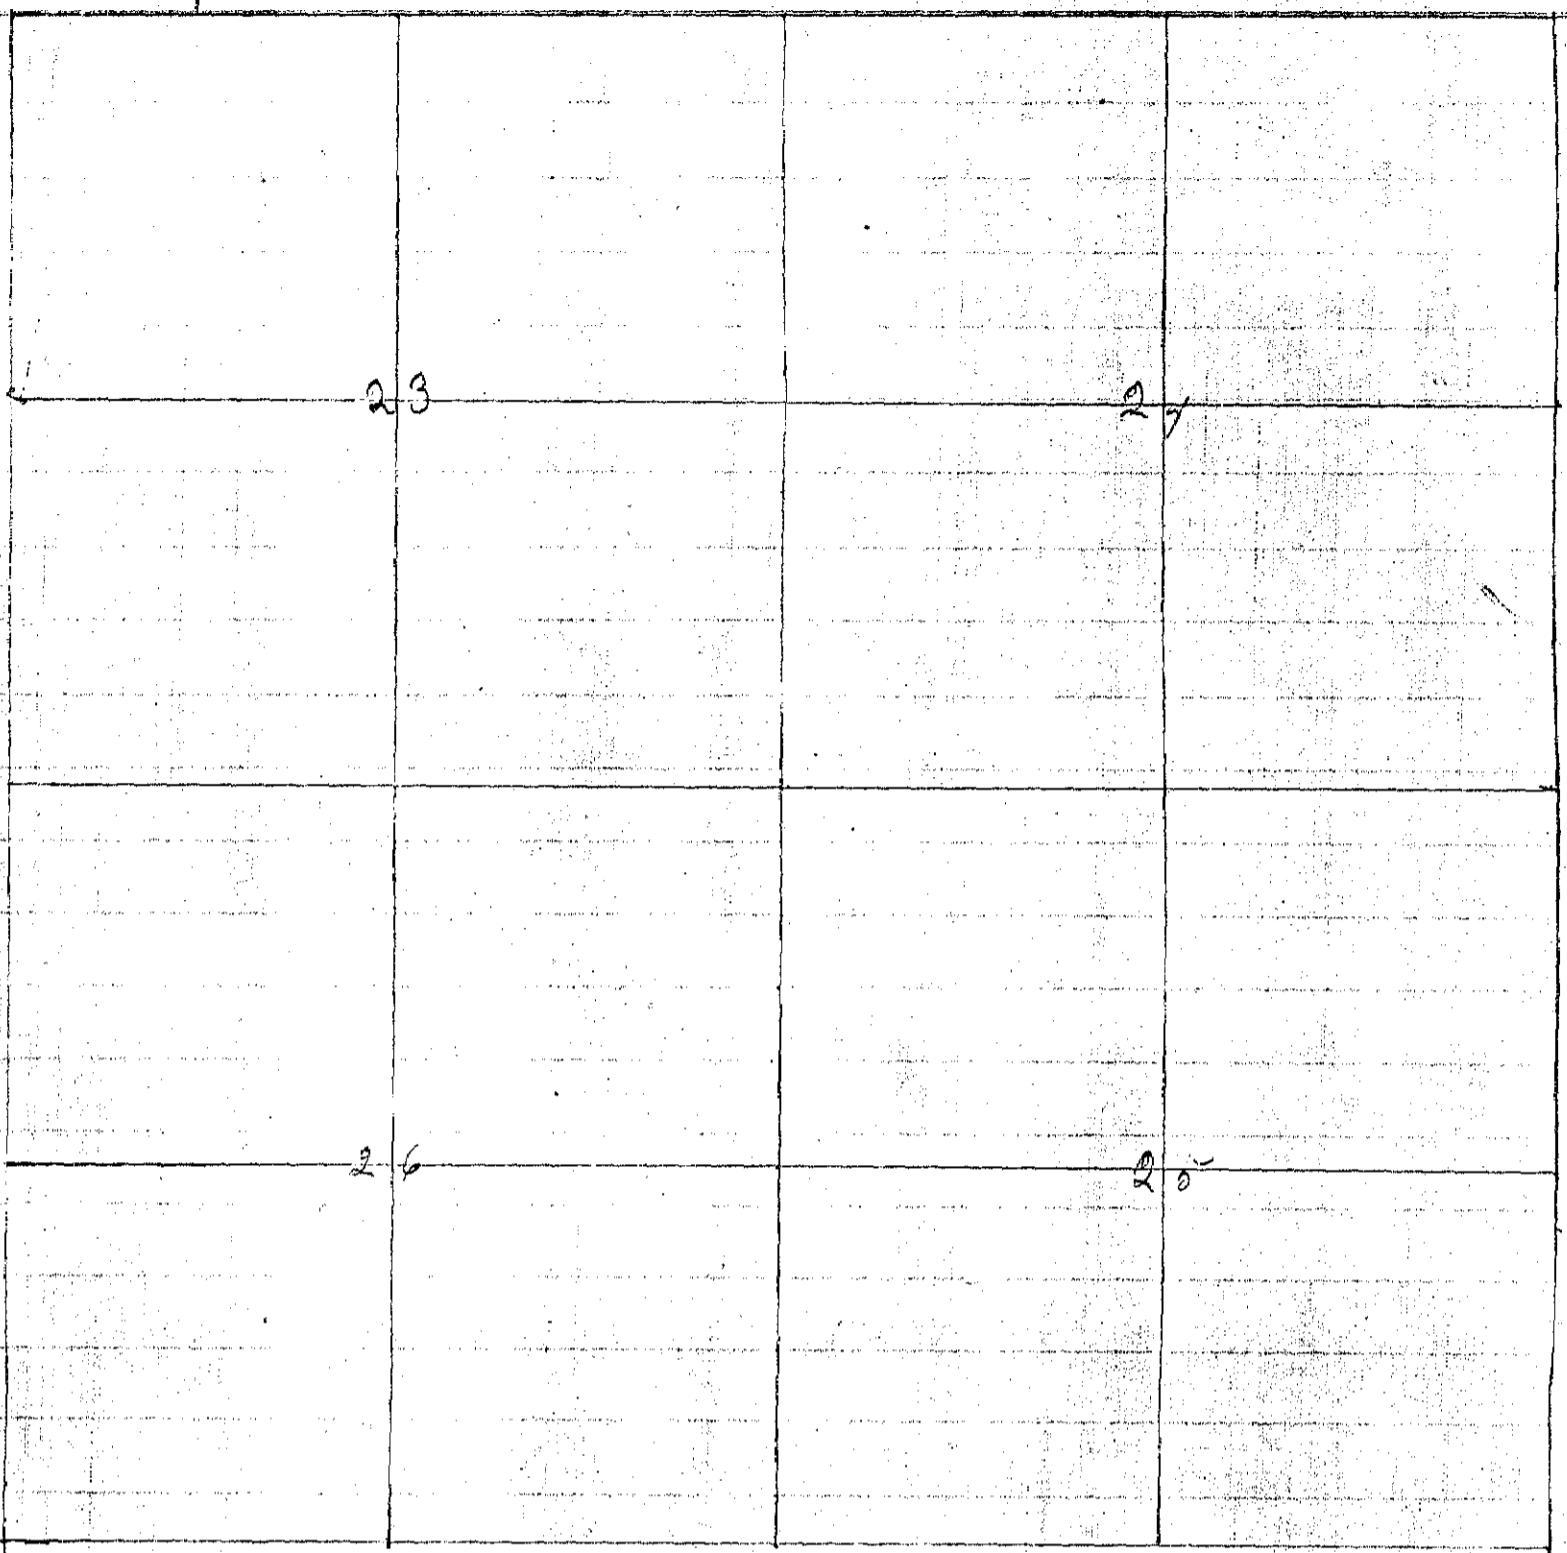

For to Ashby Car Hewitt et al  
 commenced at the corner to 24 x 25 x 35 x 36  
 thence ~~South~~ North Ver 20° E

Set 1/8 corner

thence N found 1/4 corner in mound of Rock

" " set 1/8 "

" " found no corner to sections 23 x 24 x 25 x 26

I then commenced at the section corner to sec 23 x 22 x 27 x 28

thence East found 1/4 section corner in mound of Rock

" " set 1/8 "

" " set temporary section corner to sec 23 x 24 x 25 x 26

I then commenced at the cor to 24 x 25 x 19 x 30

thence West Ver 21°

found 1/4 corner 75 lks west thence west

to temporary corner to 23 x 24 x 25 x 26

I then commenced at the corner to 23 x 24 x 14 x 18 thence South Ver 20°  
 found 1/4 corner thence South  
 " temporary corner thence N 1/4 lks set section corner to 23 x 24 x 25 x 26  
 Rock 7 x 6 x 20 marked with 1 stake on E 2 stake on S 3 on N 4 on W

20  
20  
20  
19 95  
40  
20  
20  
40  
40  
40 3