

314
1895


RECORD OF SURVEY

183

Township No 4 South Range 40 East Union County, Oregon.

Warden Hathaway Ditch

CHAINS. LKS.

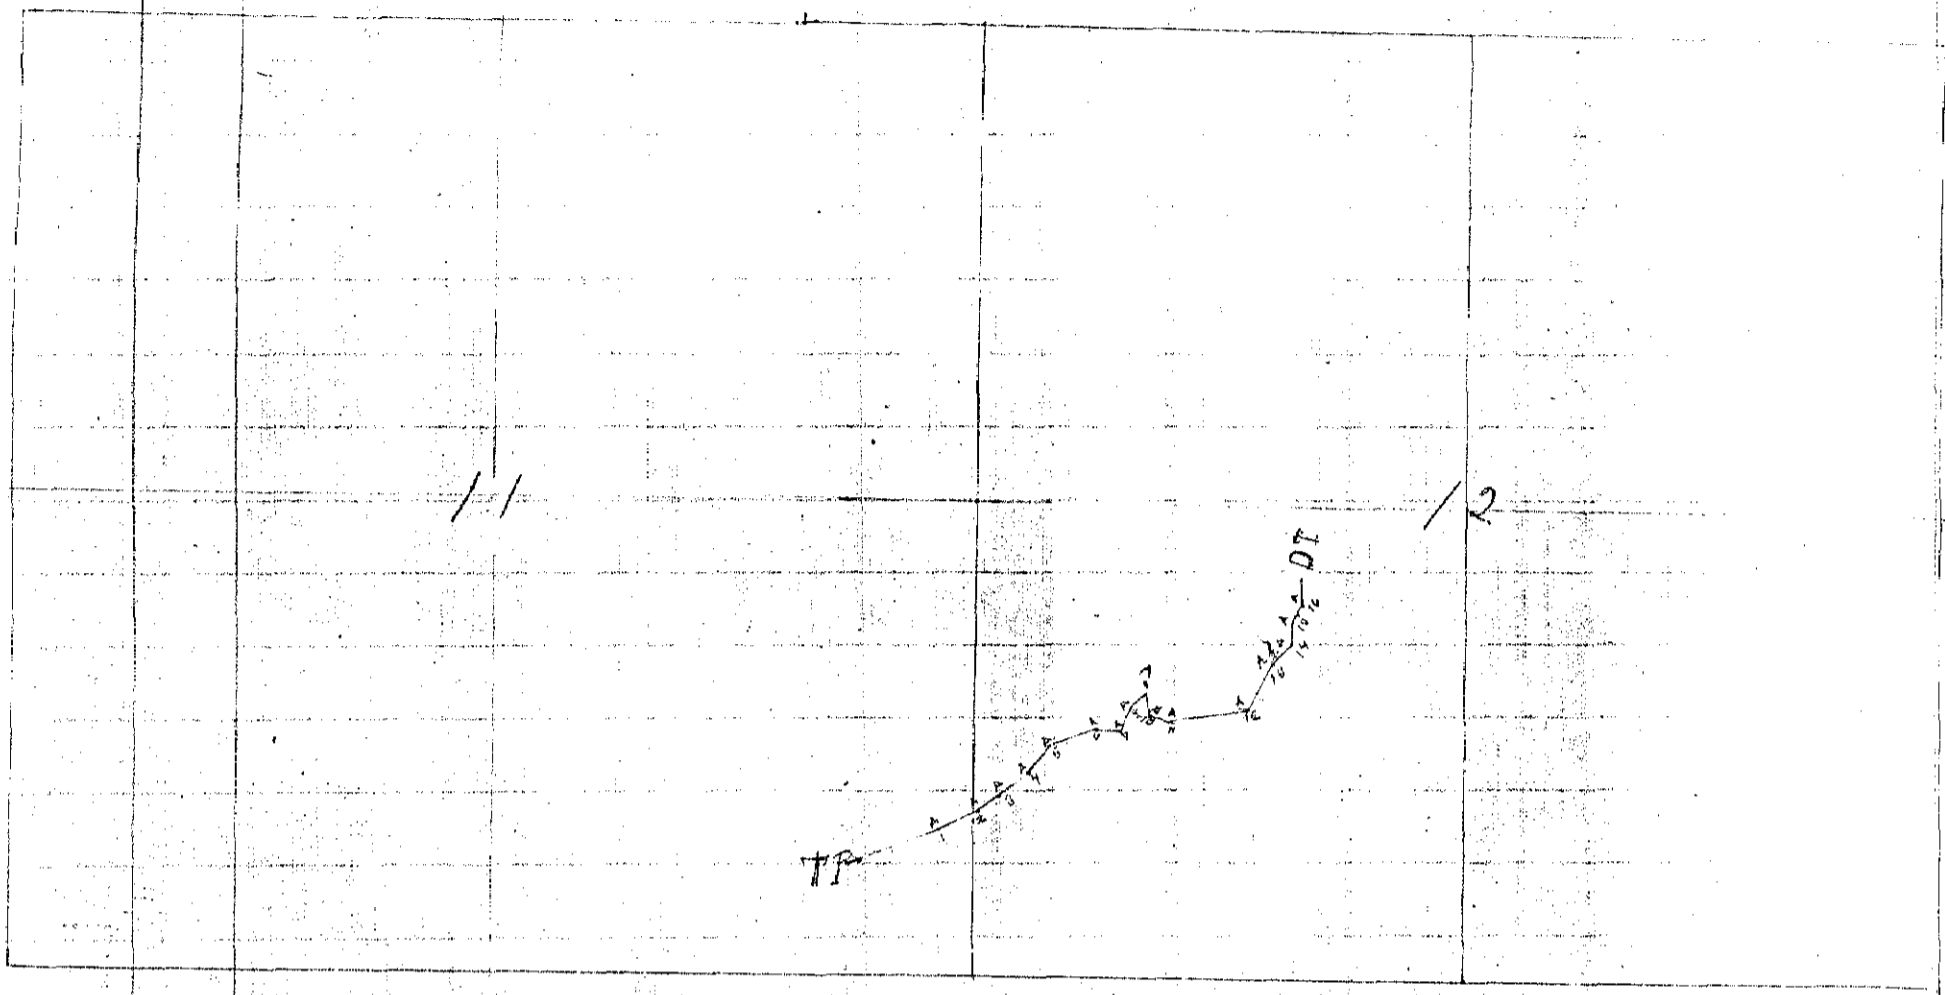

Beginning at a point 54 Rods 8 Lks 45° East of North from the East corner of section 11 Town 4 South of Range 40 East of Willamette Meridian.

Rods	Lks	Bearing	Distance	Direction
34	three	East	24°	North
18	"	"	28	"
14	"	"	41	"
12	"	"	37	"
14	"	"	54	"
20	"	"	20	"
8	"	"	2	South
10	"	"	45	North
8	"	"	40	"
8	"	South	15	East
8	"	East	20	South
24	"	"	10	North
20	"	"	8	"
12	"	"	63	"
8	"	"	50	"
8	"	North	10	East
8	"	"	20	"
4	"	"	2	"
	"	"	2	"

W B B. Baker County Surveyor