

RECORD OF SURVEY

1874 187

Township

No 4

South


Range

40 & 41

Union County, Oregon.

CHAINS.

LKS.

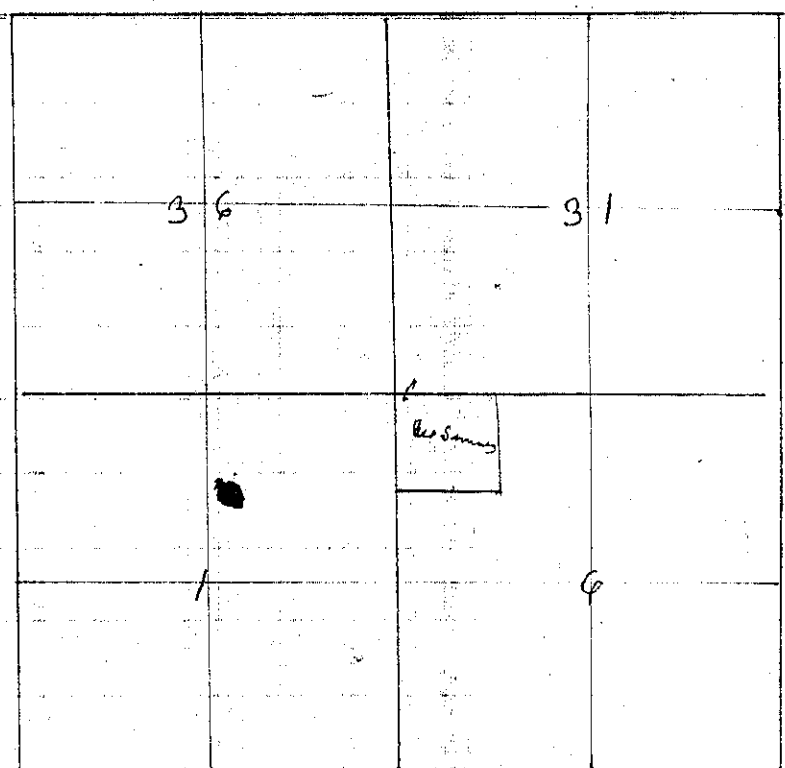

George Simmons Logging Ditch

Beginning at a point 12 Rods 36° north of East
 from the section corner of sections 1-9-31-34 on
 Range line between Ranges 40 & 41 E in
 thence South 50° west 5 Rods to stone marked A
 " " " 6 " " 3 " & 12 Rods " " " B

W.B. Blakeslee

County Surveyor

Surveyed Aug 2^d 1895