RECORD OF SURVEY

323

No. 170

Township 3 S Range 40 E W M Union County, Oregon.

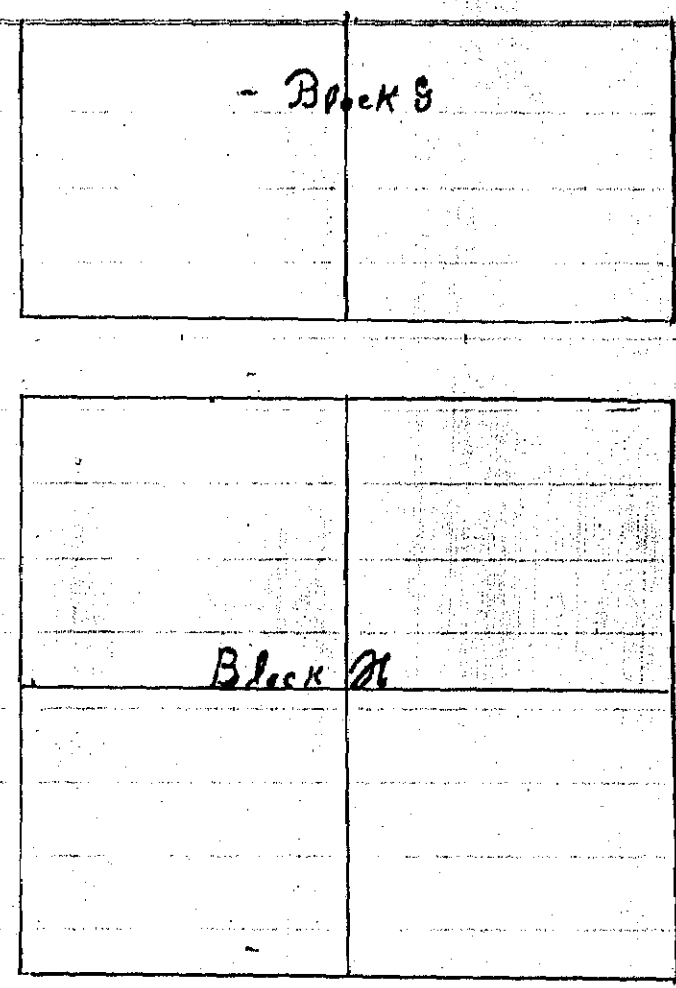

McDaniels Adition to the Cove.

Commencing at a point 844ft west & 1774ft North of the S E corner of Section 16 Town 3 S of Range 40 E W M thence East 40ft to place of Beginning thence North 150ft to the center of Block D on the west Boundary and drove a stake 4x4 thence North 150ft to the N W corner of Block D. thence East 150ft to center of . . . on N Boundary drove stake 4x4 thence East 150ft to the N E corner of Block D Beginning at a point 40ft N W corner of Block D S E Stake 4x4 thence North 150ft drove Stake 4x4 for center on west boundary of Block H thence North 150ft to the N W corner of Block H drove stake 4x4 thence East 150ft drove stake 4x4 for center on North boundary of Block H thence East 150ft drove Stake 4x4 for N E corner to Block H. thence South 150 ft drove Stake 4x4 for center on East Boundary of Block H . . . . . S E corn Block H thence West 150ft drove Stake 4x4 for center on South boundary of Block H . . . . to the place of Beginning

Beginning at a point 40ft North of the N W corner of Block H
thence North 150ft Drove stake 4x4
" East 150 " " " " for center to Block G
" " 150ft " " " "
" South 150 ft " " " " South East corner to Block G
" West 150 " " " " for center on South boundary " "
" 150 " to place of Beginning

W B Blakesley
County Surveyor