

N. <sup>171</sup>/<sub>188</sub>

Township 3 South

Range 38 East W.M.

Union County, Oregon.

Frank Owsley Aug. 28<sup>th</sup> 1896

I commenced at the  $\frac{1}{4}$  Sec. Cor. on the South side of Sec. 35 T. 3 S. R. 38 E.

Thence West Var. 19° 30' East

Set temporary  $\frac{1}{8}$  Cor.

" " Cor. to Sections

34-35 T. 3 S. and 2-3 T. 4 S. R. 38 E.


The  $\frac{1}{4}$  Sec. Cor. between Sec. 34 T. 3 S. & 3 T. 4 S. R. 38 E.

Then I went back on line

Found Original stake Set post 4x4x42 for Cor. to Sec. 34-35 T. 3 S. 2-2 T. 4 S.

Set a stake for the N.E. Cor. of the N.W.  $\frac{1}{4}$  of the the N.W.  $\frac{1}{4}$  Section 35 Township 3 South Range 38 East W.M.

Arthur Curtis  
County Surveyor

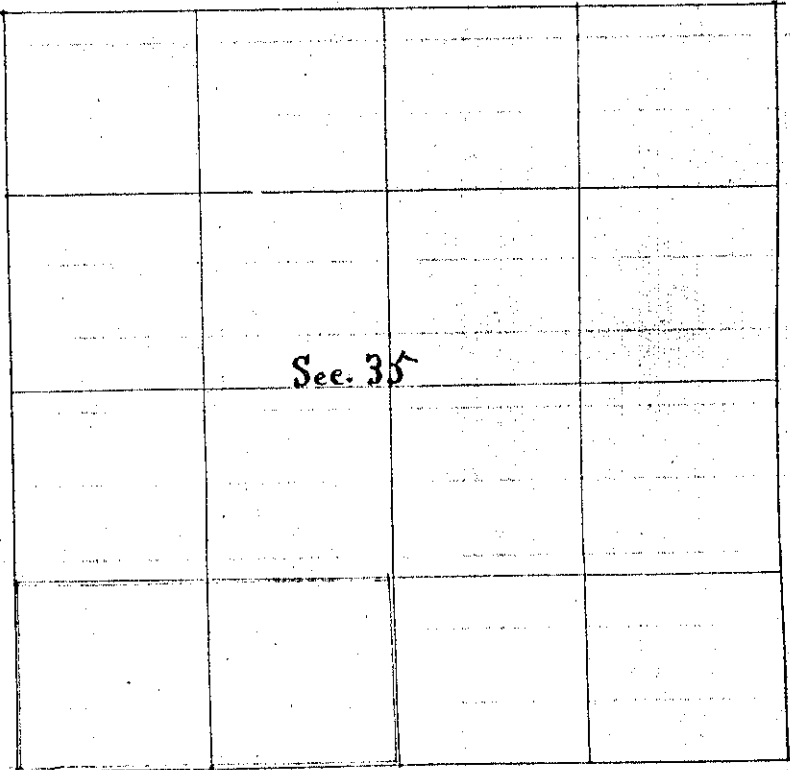

189.  
20  
0  
045  
80 12  
40 06  
60 09