

1896

RECORD OF SURVEY

112  
No. 189

Township 1 South

Range 39 East W.M.

Union County, Oregon.

CHAINS. LKS.

Sabe Choate Mar. 17. 1896

I commenced at the 1/4 Sec. Cor between 7-18 Then North

20 Set Temporary corner

40 " " "

60 To corner Then from 1/4

80 Sec. Cor. between 7-12 East to corner 4 lks south of corner set for center section, I then buried a rock 12x16x8 in for corner. Then East

20 Set Corner Stake, Then from Center Section South

23 97 " Stake. Then East

16 19 To Center creek Then following said creek to corner containing North 34° West

3 15 Then North 25° East

2 36 " " "

3 30 " " 40° "

1 30 " " 3° West

4 40 " " 77° East

2 25 " " 60° "

2 25 " " 6° West


1 70 " " 80° "

3 90 " " 40° "

4 40 " South 85° East

4 00 " North to corner

3 30 Containing 40 Acres More or less

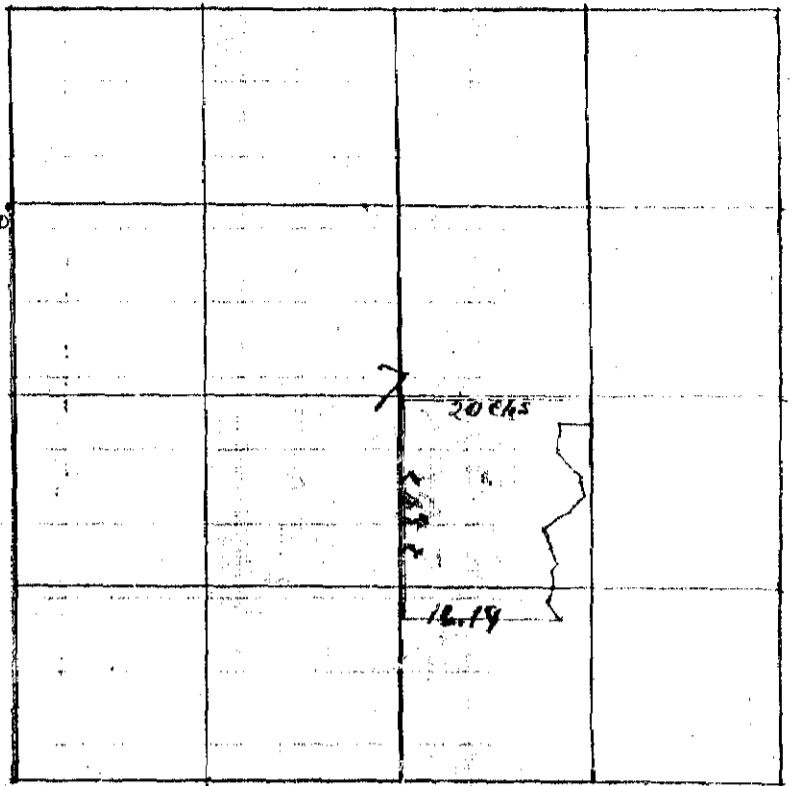

Arthur C. ...  
County ...