

RECORD OF SURVEY

71¹¹
1914

Township 2 North Range 39 East W.M. Union County, Oregon.

L.S. L. B. Hendricks April 28 1897

I commenced at the corner to Sec 30-31
29-32 Thence West Var. 20° East

Set temporary 1/8 corner

The 1/4 Sec Cor. Thence East

Set corner stake with witness trees

A fir 1 foot diameter South 45° East 20 lks

" " 1/2 " " North 40° West 23 lks

Then South from Cor.

Set stake, Then from 1/4 Sec. Cor. between
30-31 South

Set Stake

Then from 1/4 Section Cor.
between 29-30 West Var. 20°

Set Temporary stake

" " "

" " "

to line 50 lks North of Cor. back on true line

Set 1/6 Cor. With B. T. South 80° East 34 lks distance 8 inches in diam

" Cor. for Center Section (a fir 2 ft diameter bears S. 45° East 5 links distance

" 1/6 Cor. stake (a fir 8 inches in diameter bears South 80° West 4 lks distance

Then South from Cor.

Set temporary Corner

To Sec. line 20 lks East of corner

Then from 1/4 Sec. Cor. between Sec. 30-31 North

Set temporary Corner


To Center of Section stake

Then from the N. W. Cor. of the N. E. 1/4 of the S. W. 1/4 Sec. 30

T. 2 N. R. 39 E. South

Set stake Then East

To Center line at 1/6 Cor.

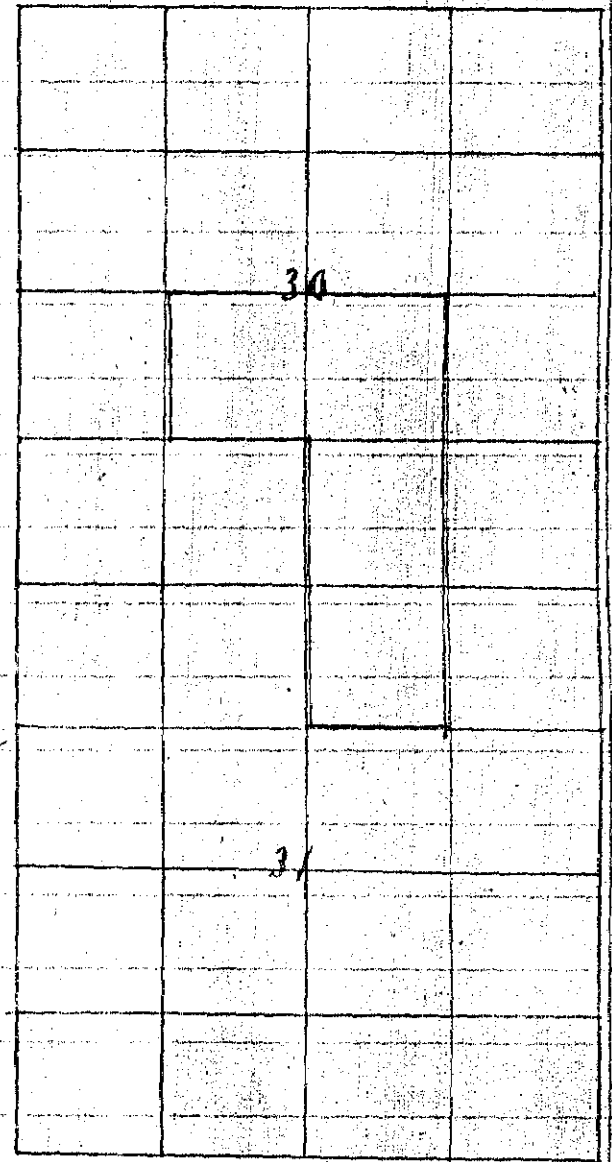

A. Curtis
County Surveyor