

RECORD OF SURVEY

118  
7m 195

Township 2 North Range 38 East W. 711. Union County, Oregon.


CHAINS.  
LKS.

Louis Proctor et al. May 20, 1897

I Commenced at the 1/4 Sec.  
Cor. between Sections 25-36  
and run South Var 19° 30' East  
Set Temporary Stake

20  
40  
60  
82

20 To Sec. line 2 Chains West of  
1/4 Sec. Cor. back on true line  
Var 21° East

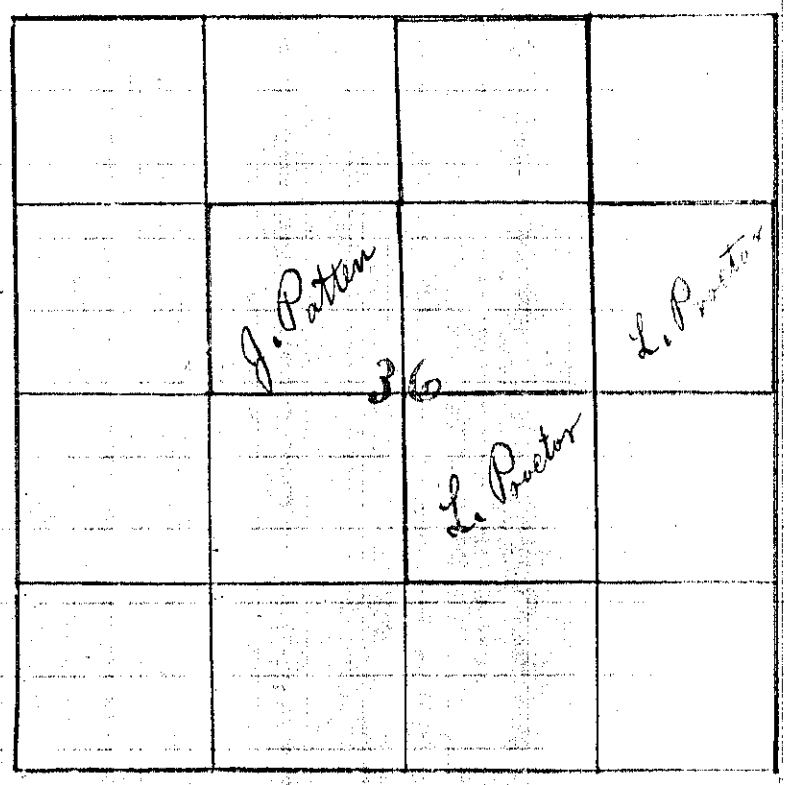

20  
41

55 Set 1/16 Cor.  
10 " Center Section

61  
20

65 " 1/16 Cor. Then from Center Section East  
Set Stake

41  
20

To Sec. line 50 links South of 1/4 Sec. Cor. back on true line  
Set 1/16 Cor.

41

Center Section from which a pine tree bears N. 70° West  
10 lks distance A Fir 8 inches in diameter bears South 65°  
East 15 lks. distance Then North from 1/4 Sec. Cor. between 36-31

20  
20

50 Set Stake Then West  
50 " Temporary Stake

41  
20

65 To Center line at 1/16 Cor. Then from 1/4 Sec. Cor. to line  
25-36 East

20  
20

50 Set Stake Then South  
50 To 1/16 Corner

41  
61

60 " Center line E. W. at 1/16  
30 Set 1/16 Cor. Then West.

20

50 To Center Line running N. S. at 1/16 Cor.

Arthur Curtis  
County Surveyor