

# RECORD OF SURVEY

333  
1897

179  
No. 196

Township 2 South Range 37 East W.M. Union County, Oregon.

MIN. LRS.  
20  
40  
60  
80  
25  
43  
66  
86  
20  
20  
40  
20

Jim White June 1897

I commenced at the  $\frac{1}{4}$  Sec. Cor. on East side of Section 22 Then West Var.  $29^{\circ}$  East

Set Temporary Corner

" " "

" " "

To Sec. line 110 chs South of Cor.

There being an excess on West side of 4.80 chs I have an excess of 1.60 chains back on true line Var.  $19^{\circ}30'$

Set  $\frac{1}{16}$  Cor.

Set Stake

Set Stake


To  $\frac{1}{4}$  Section Corner Then from  $\frac{1}{4}$  Section Corner on North side of Sec. South West

To  $\frac{1}{8}$  Corner a Stake Then South

Set Temporar Corner

To Center line 70 links West of  $\frac{1}{16}$  Cor. back on true line

Set Corner for  $\frac{1}{16}$  a stake

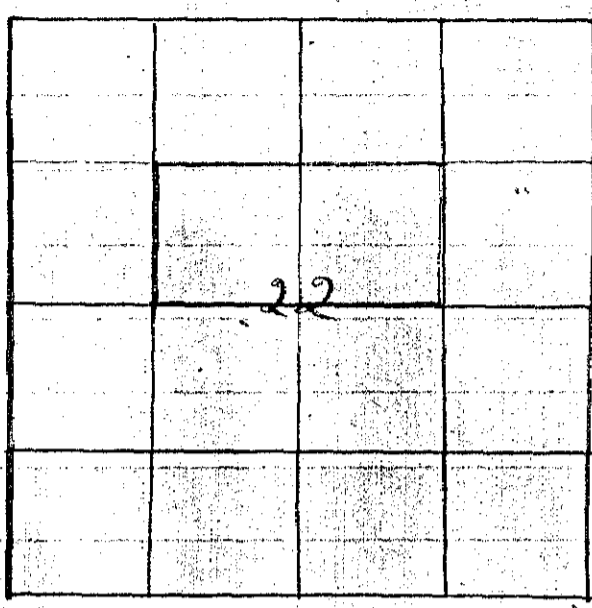

Arthur Curtis  
County Surveyor