

RECORD OF SURVEY

335
1898

181
No. 198

Township 2 North

Range 40 E. W. 7N

Union County, Oregon.

Mr John Miller

March 9. 1898

I Commenced at the 1/4 Sec. Cor.
between Sections 17-18 and run thence

East

Set Temporary Stake

" " "

" " "

The 1/4 Sec. Cor. between Secs 16-17

Thence West

Set Stake


" Stone for Center Section

" Set Stake

Then from the 1/4 Section Cor. on North side of Sec. 17 South

To stone set for center Section

The 1/4 Sec. Cor on South side Sec. 17 T. 2 North R. 40 E. W. 7N.

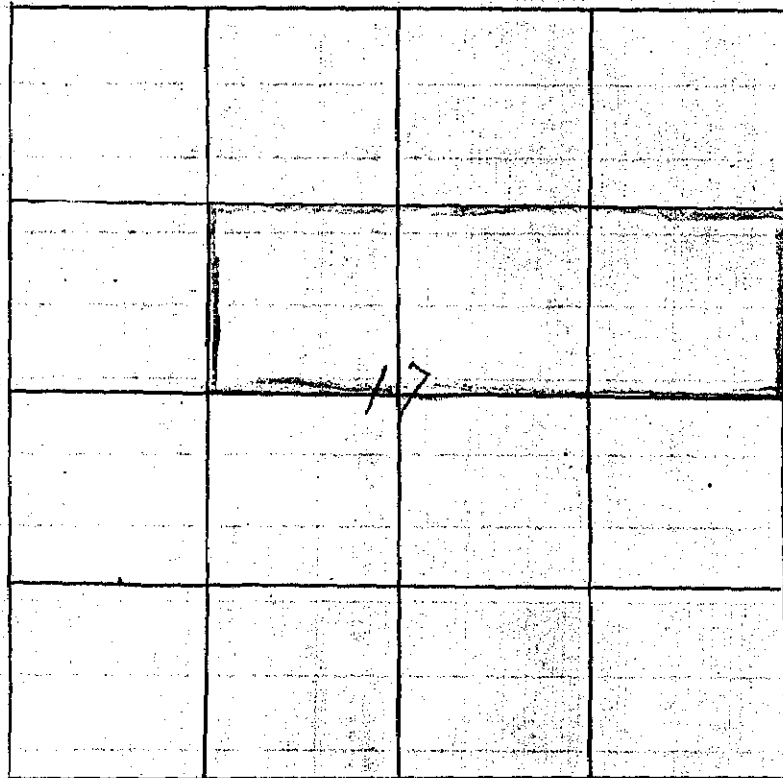

20
40
60
80 20
20 0.5
40 10
60 15
40
80

Arthur Curtis
County Surveyor