

RECORD OF SURVEY

339
1898

189
201


Township *4 South*

Range *38 East W. M.*

Union County, Oregon.

R. J. Body
Oct. 17-1898

I commenced at
Sec. Cor. to Sec. 23-24-25-
26 and run South
Var. $21^{\circ} 30'$ East
Set temporary Cor.
The Sec. Cor. to Sec.
25-26-35-36 Then
North from Cor.

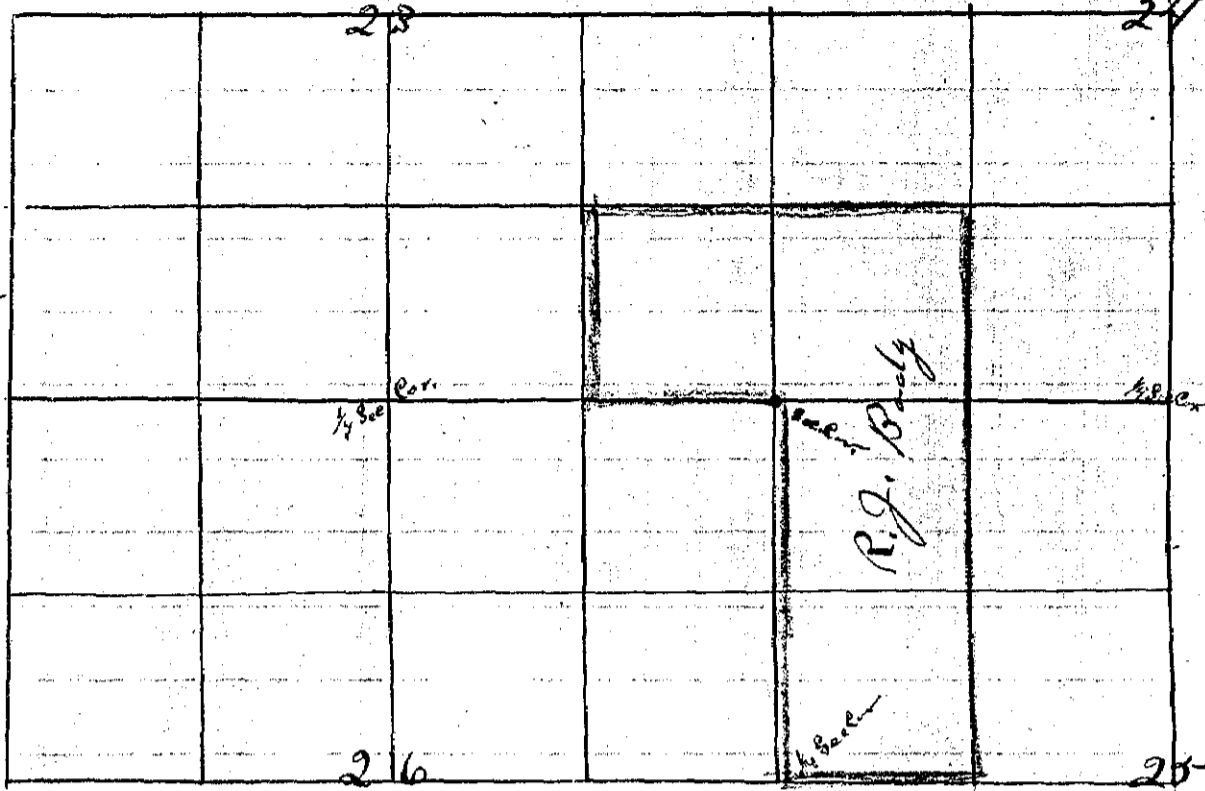

- 40 79 96 Set marked stone for $\frac{1}{4}$ Sec. Cor. then East
- 20 Set Temporary $\frac{1}{16}$ Cor. Then North
- 40 00 To Sec. line running East and West, Then from Sec. Cor. 23-24-25-26 I run East
- 20 Set temporary Corner
- 40 The $\frac{1}{4}$ Sec. Cor. 1 chain North of Cor. Then West from $\frac{1}{4}$ Sec. Cor. on true line
- 20 Set $\frac{1}{8}$ Sec. Cor. Then North
- 20 " Temporary $\frac{1}{16}$ Sec. Cor.; Then from Sec. Cor. 23-24-25-26 West
- 20 " $\frac{1}{8}$ Sec. Cor.
- 40 The $\frac{1}{4}$ Sec. Cor. Then from $\frac{1}{8}$ Sec. Cor. North
- 20 00 Set $\frac{1}{16}$ " " ; " East
- 20 00 Section line running North South
- 40 00 The $\frac{1}{16}$ Section Corner

Arthur Curtis
County Surveyor