

Township 3 South Range 36 East W. M. Union County, Oregon.

CHAINS. LKS.

Gus Benglesdorf

I commenced at the 1/4 Sec. Cor. between Sec. 21-28 and then run South Var. 20° East

40 Set Temporary Cor.

82 60 The Sec. line 1.90 Chs. East of Cor. then back on true line

41 30 Set Temp Center Sec. then from 1/4 Sec. Cor between Sec. 27-28 East

41 To center Sec.

61 Set Temporary Cor.

82 To 1/4 Sec. Cor. then East

20 50 Set 1/6 Sec. Cor a stake 4 inches square from which a pine tree 30 in. in diameter stands South 2.13 Chs. a pine 20 inches in diameter stands North 80° West 16.2 Chs distance

Then from 1/4 Sec. Cor. between Sec. 28-³³~~29~~ West

20 Set Temporary Cor.

40 50 The Sec. Cor to Sec. 28-33-29-32 then East


20 25 Set 1/8 Sec. Cor a stake in mound of rock then South from Sec. Cor to 28-33-29-32

40 50 the 1/4 Sec. Cor. then East

20 25 Set stake for Cor. Then North

20 25 " " " "

40 50 The 1/8 Sec. Cor.

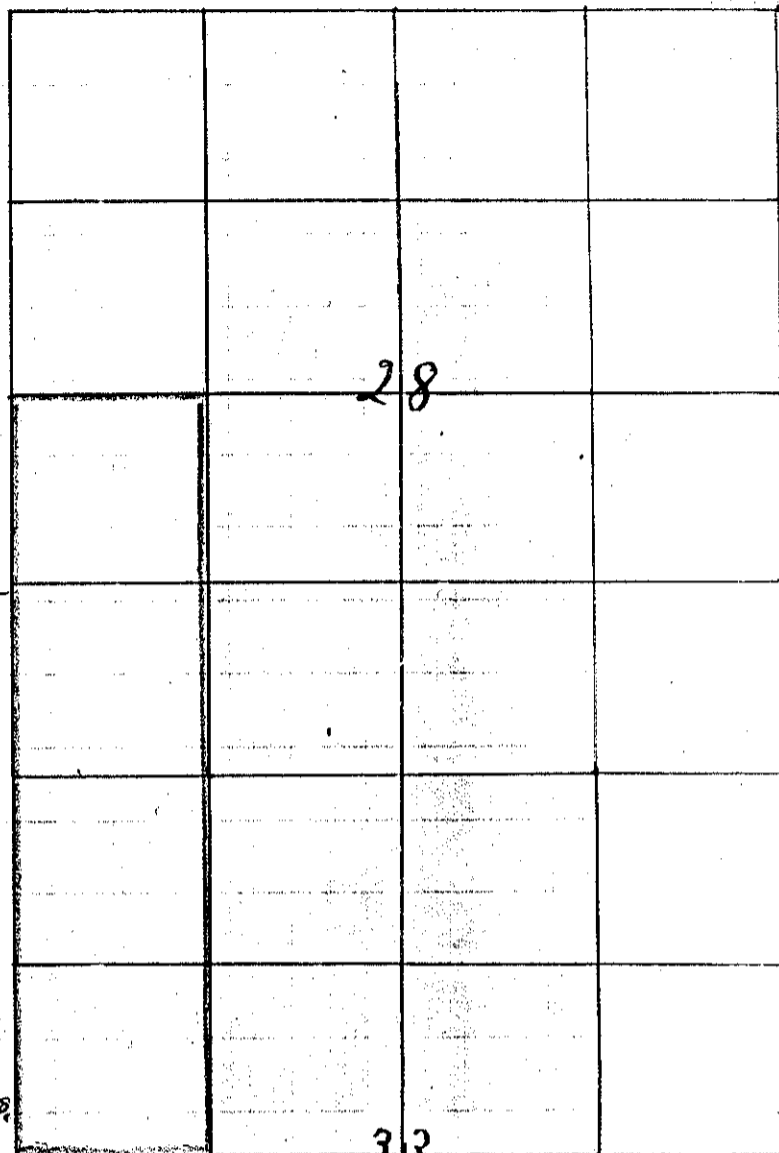

Arthur Curtis
County Surveyor