

Township 1 South Range 39. East W. M. Union County, Oregon.

CHAINS
LKS.

J. Gaskil March 3-1899

I commenced at the North West
Cor. of Section 33 thence South
Var. 19° 30' East

40 Set Temporary 1/4 Sec. Cor.

60 " " 1/8 " "

80 36 The Sec. line, 78 lks East of the
Cor. Stone then South on true
line

20 09 Set 1/8 Sec. Cor. a stone

40 18 " 1/4 " " a marked stone 12-16-8 inches

Then from North East Cor. of Section 33 South

40 Set Temporary Corner

60 " " " "

80 50 the South East corner of Section 33 then North

20 12 1/2 Set a stone 16-8-6 inches for 1/8 Sec Cor.

40 25 " " " 18-12-8 " " 1/4 " "

Then from the North East Cor. S. 33 West


20 Set Temporary Cor.

37 East bank of River

40 West " " " "

80 33 the N. W. Cor. of Section 33 Then East

60 24 Set a stake for 1/8 Section Cor.

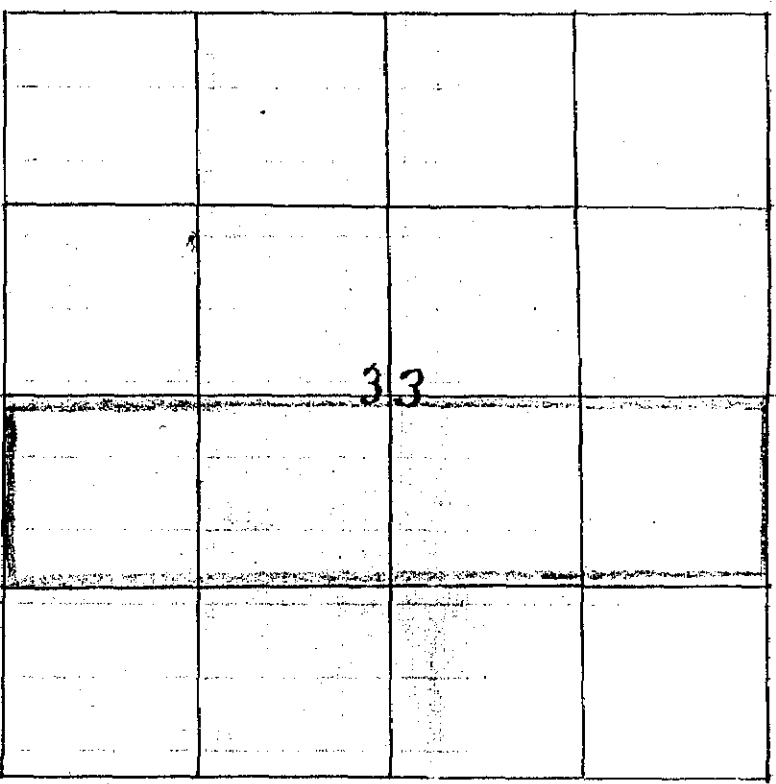

Arthur Curtis
County Surveyor