

# RECORD OF SURVEY

367  
1931


Township 15

Range 38 E.W.M.

Union County, Oregon.


Survey For Emma Booher July 14-1921

T. 15. R. 38 E.W.M.

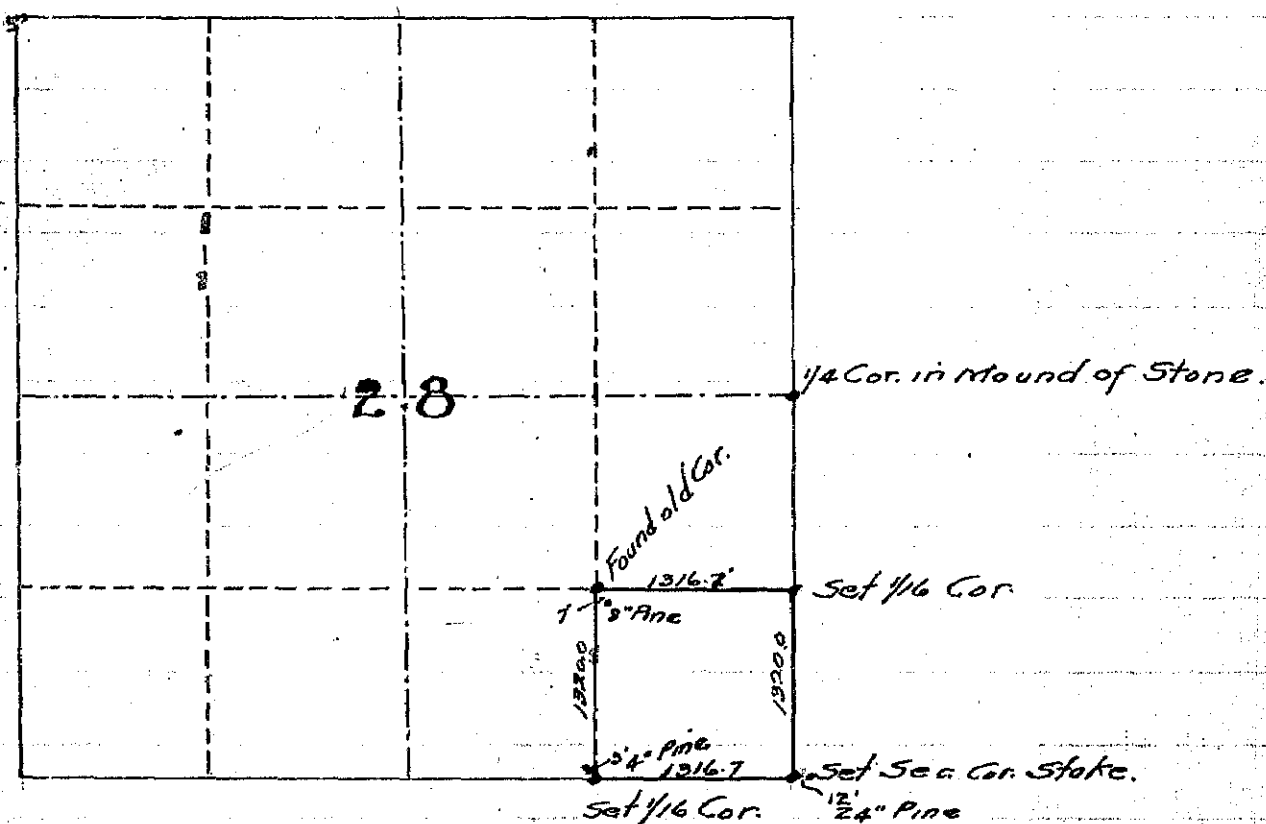

I commenced at the 1/4 Cor. between Sec. 28 & 29 T 15 R 38 E.W.M. and ran south 1320' and set a Post for the NE Cor. S 1/4 SE 1/4 Sec. 28, thence South 1320' where I was unable to locate Sec. Cor. 27-28-33-34 or witness trees. Set Section Stake by measurement from 1/4 Cor. South. From Sec. Cor. set 1 ran West 1316.7 feet and set post for 1/16 cor. thence North 1320.0 feet where I missed old Cor. Stake 1 W & 2' N from which point I ran 1316.7 feet East to 1/16 Cor.

Mag. Var. 18°30'

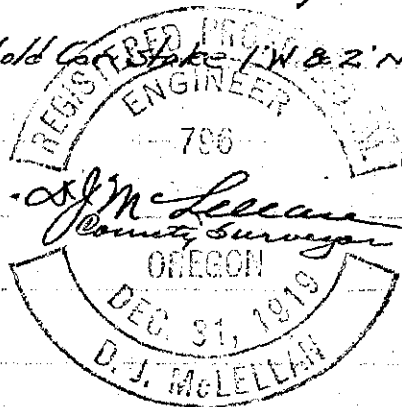

D. J. McLellan Co. Surveyor.  
Rollo Lyman  
G. F. Booher  
J. McKenzie