368
1925 +/-

RECORD OF SURVEY

210
220

Township 2 N Range 40 E Union County, Oregon.

CHAINS. LKS.

Survey for Sam Richards.

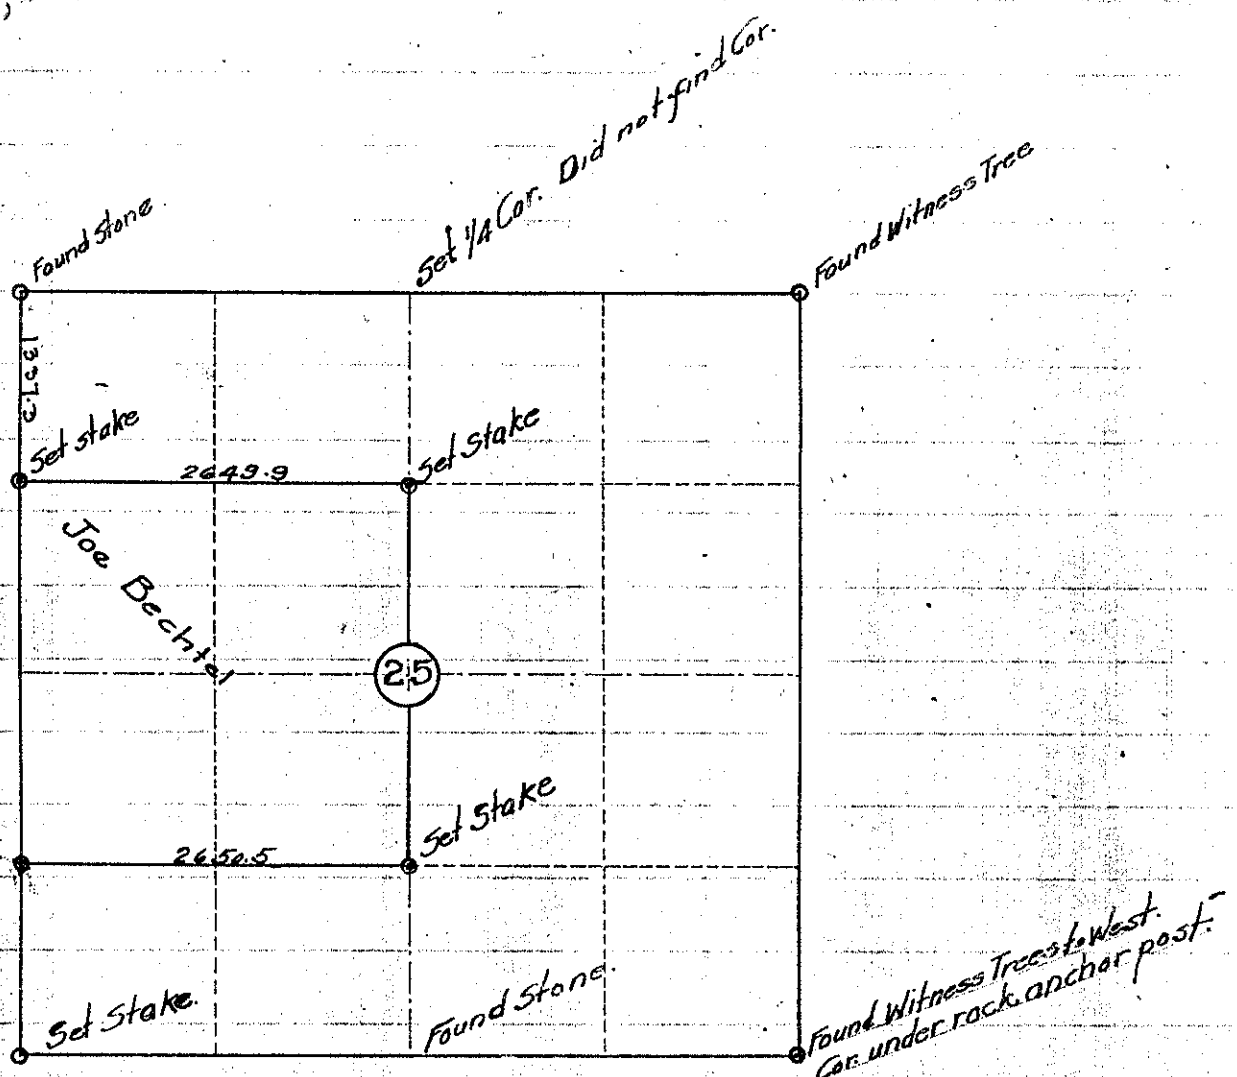

I commenced at the N.W. Cor. Sec. 25 T 2 N 40 E where I found the cor. rock; and ran east 2649.90 ft. and set temp 1/4 cor. from which point I ran on the same line 2649.8 feet to the N.E. Cor of Sec. 25. where I found a witness tree. Set 1/4 cor. on true line and ran South to the 1/4 Cor. on the South line of Sec. 25 setting the NE Cor. SE¼ NW¼ and the SE Cor. NE¼ SW¼ Sec. 25. From the 1/4 cor. on the S. line of Sec. 25 I ran east to the S.E. Cor. Sec. 25 where I found witness trees. Then produced line west from 1/4 cor. on the So. line of Sec. 25 to the S.W. Cor. Sec. 25 where I set a stake, then ran North to the N.W. Cor. Sec. 25 which I missed one foot west. Set the N.W. Cor. SW¼ NW¼ and then ran east setting intermediate stakes between this corner and the SE Cor. NE¼ NW¼ the line in question.

Var. 20° 45'

REGISTERED PROFESSIONAL ENGINEER
796
D. J. McLellan
OREGON
DEC. 31, 1919
D. J. McLELLAN

D. J. McLellan
Rollo Lyman
Sam Richards
Joe Bechtel