1931 309

RECORD OF SURVEY

Township 2 South Range 38 East Union County, Oregon.

LRS.

Survey For Oregon State Highway Department. Dec. 8, 1931.

Survey made for purpose of establishing line on gravel bar on the Grande Ronde River, between the N½ and the S½ of the S.W¼ of of Section 34, Tp 2 S. R. 38 E. W. M. Lines were run as indicated by the measurements shown on this plat. ¼ Section between Sec. 34 and Sec. 3 was re-established and referenced as shown in detail.

Var. 20° 45'

Party: Roscoe Neal. Co. Surveyor.
Dick Mollinet.
L. T. Sharinghouse.
W. C. Scull.
E. W. Erickson.

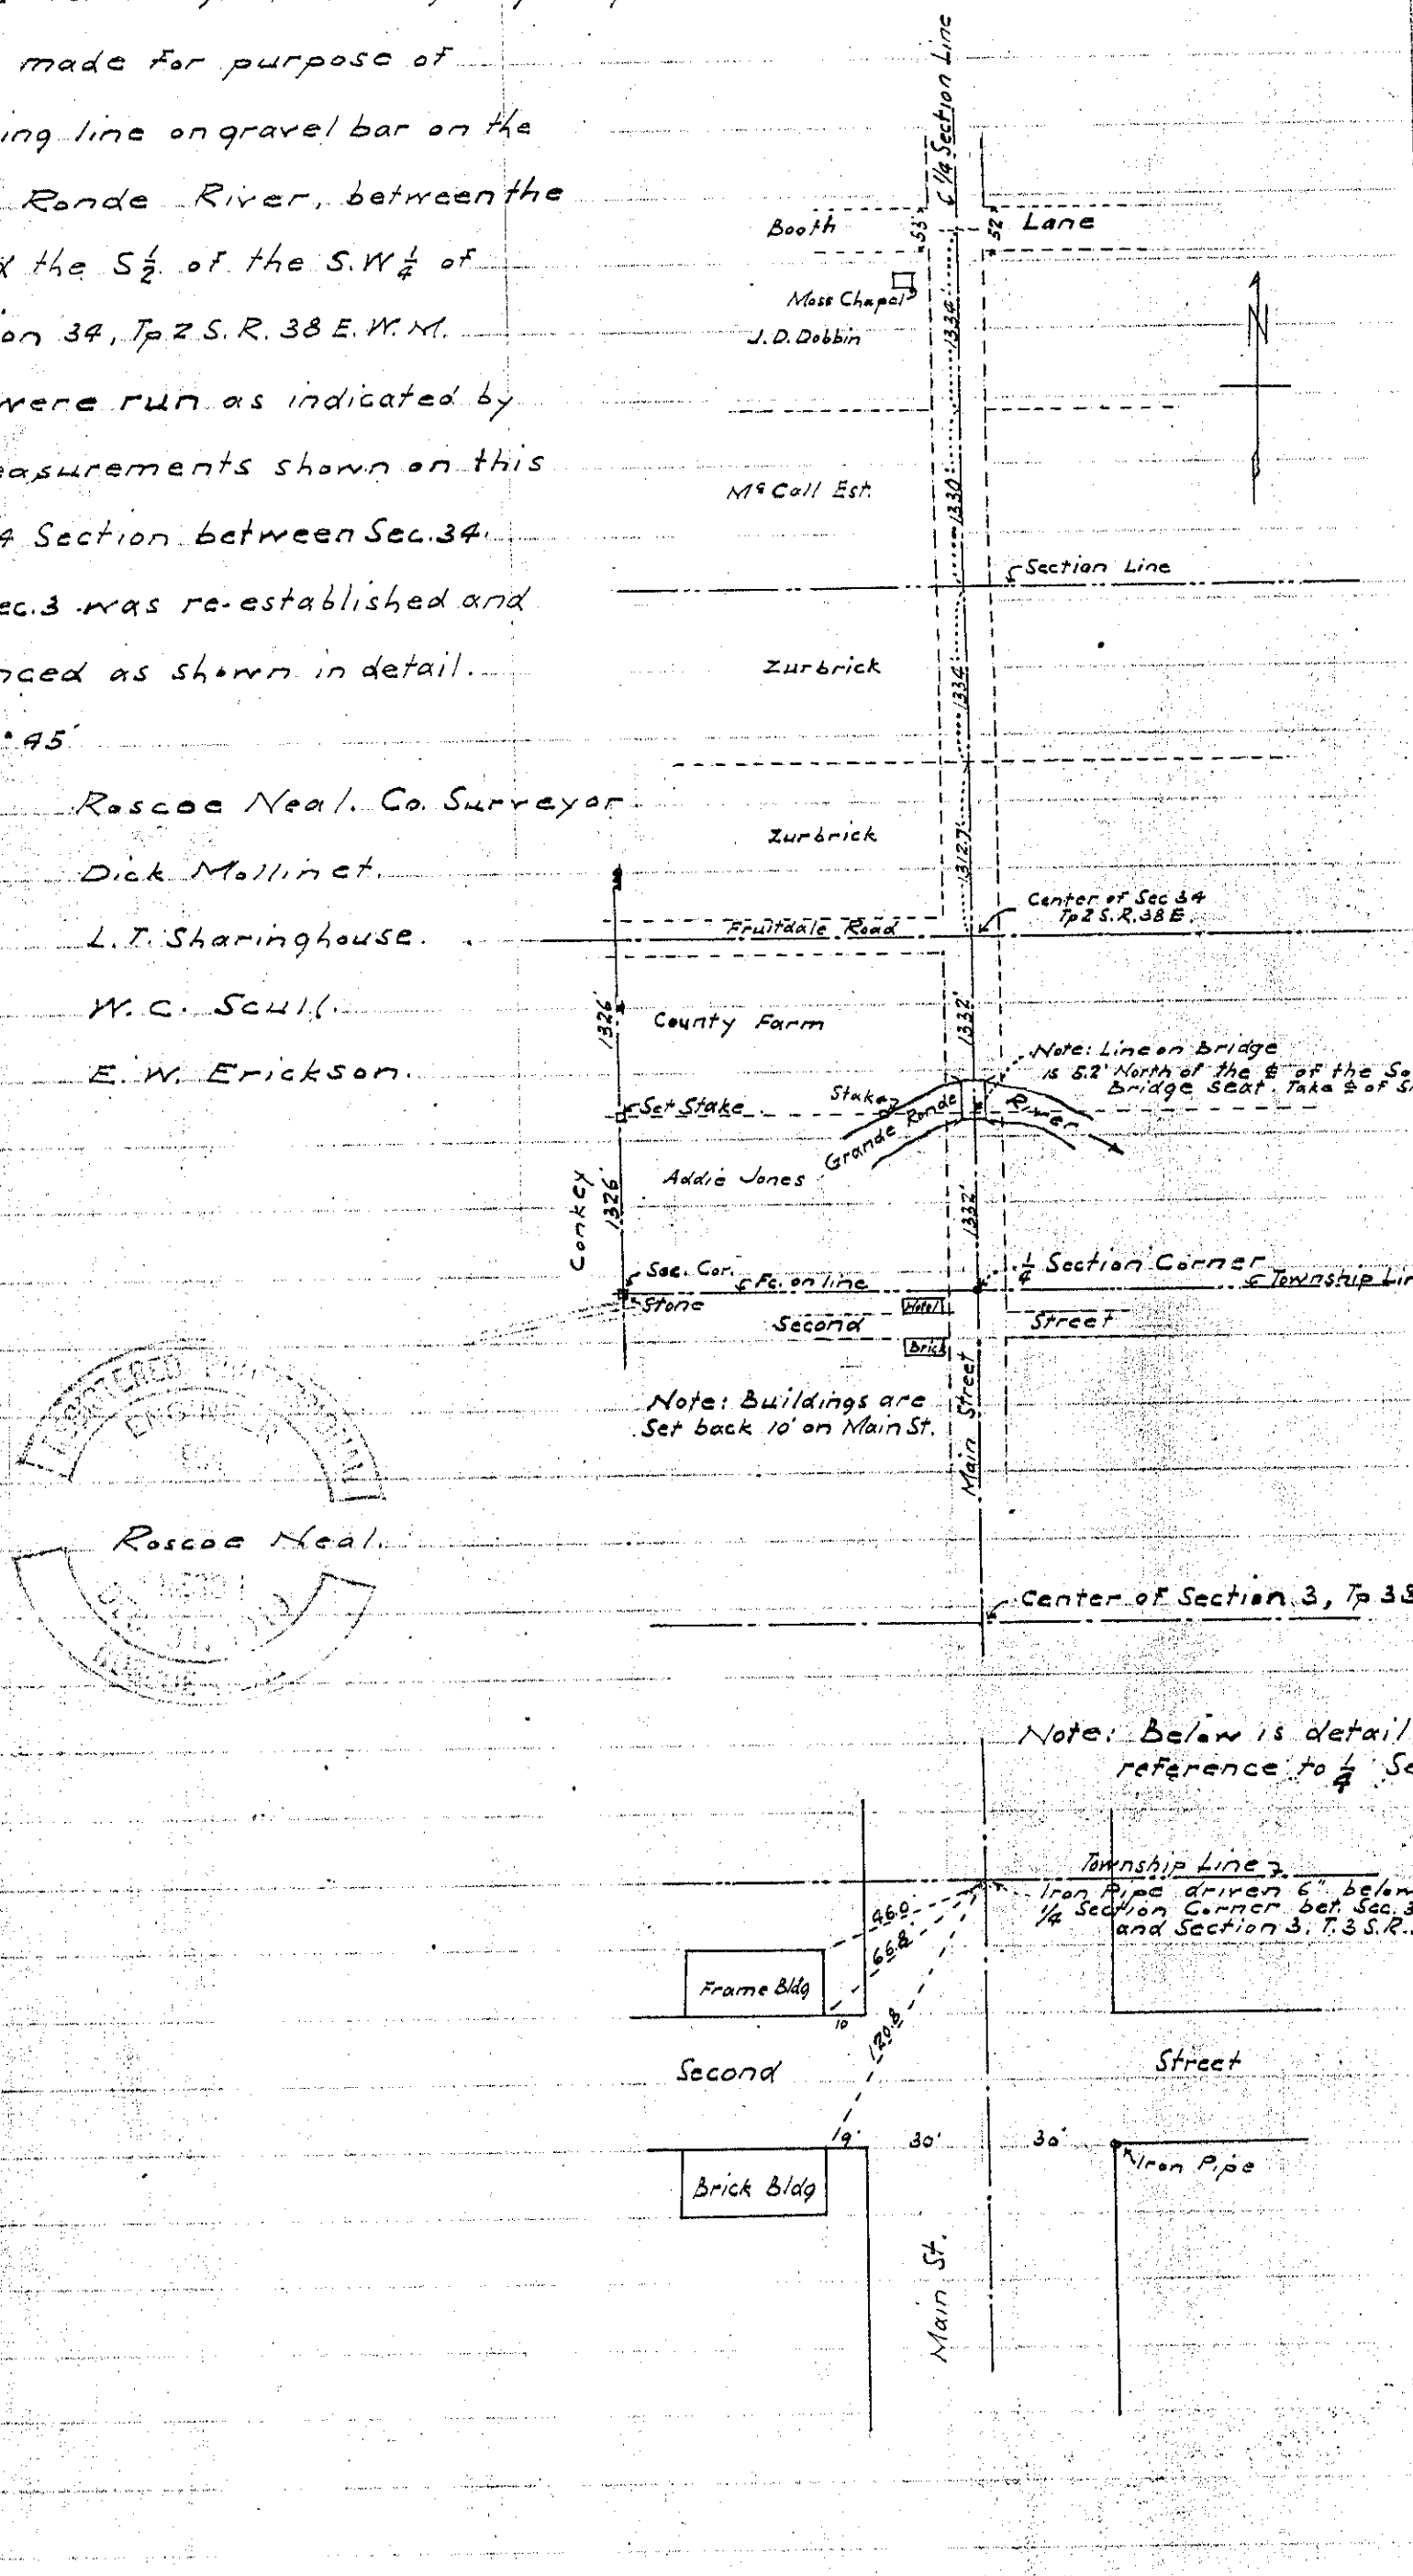

Roscoe Neal