

RECORD OF SURVEY


537

Township

Range

Union County, Oregon.

Lks.

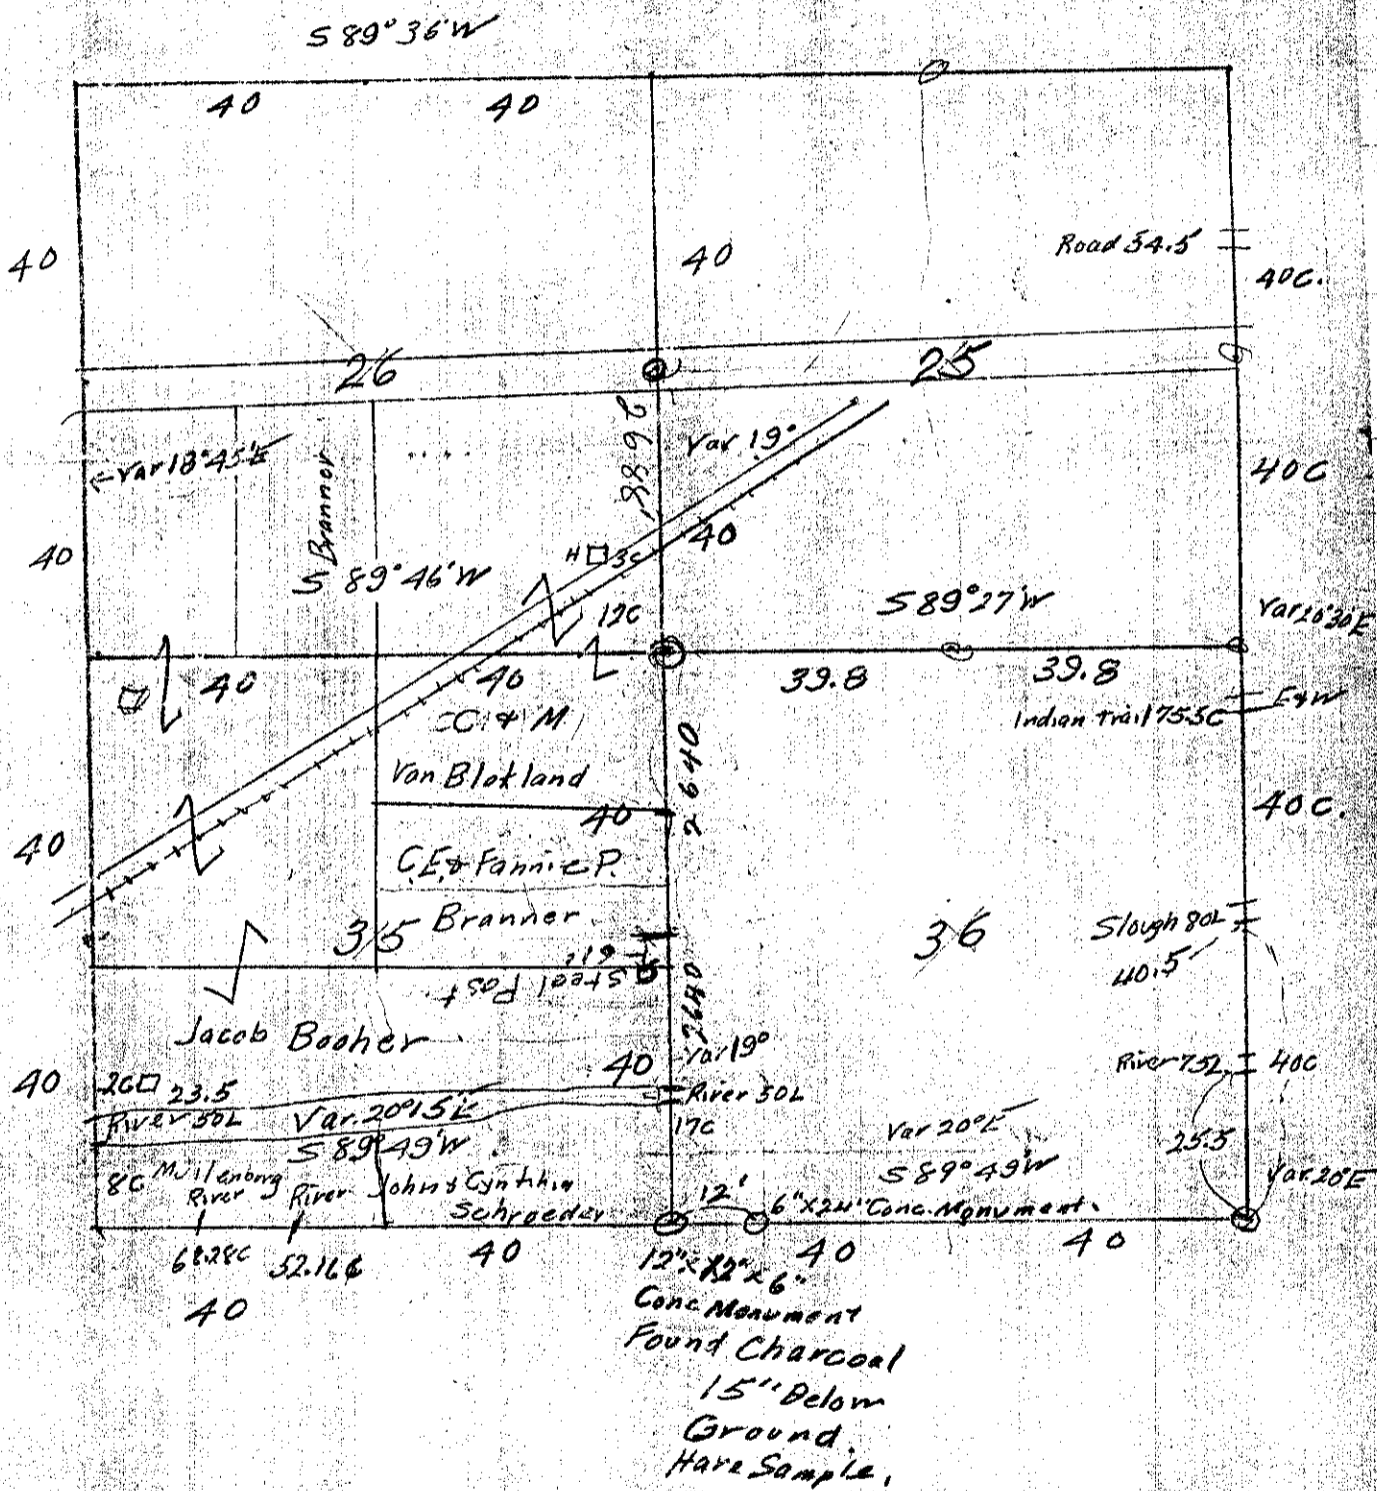

T2S R38E