


SURVEYED MAP OF THE WEST 1/2, SOUTHWEST 1/4, NORTHEAST 1/4,  
OF SEC. 14, TWP. 1N, R. 38E, WM. (Union County, Oregon)

Scale: 1" = 200'

June, 1933

Mag. Var. 20° 15' E.

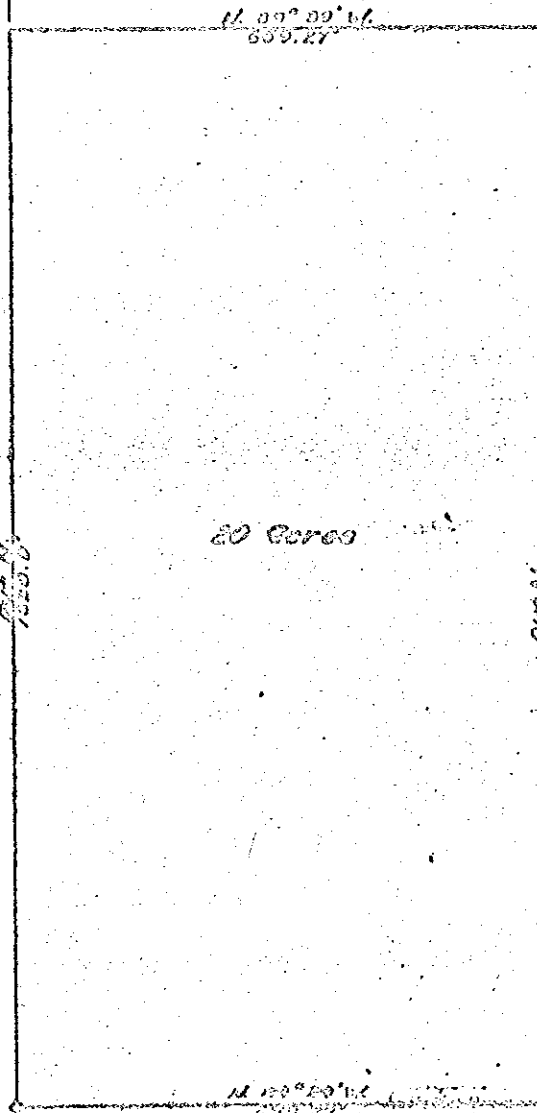

REGISTERED  
OREGON  
LAND SURVEYOR

*Ronald J. Brazeau*  
MAY 4, 1933  
RONALD J. BRAZEAU  
374

Center of Sec. 14, Twp. 1N, R. 38E, W.M.  
IN 38 SEC 14