


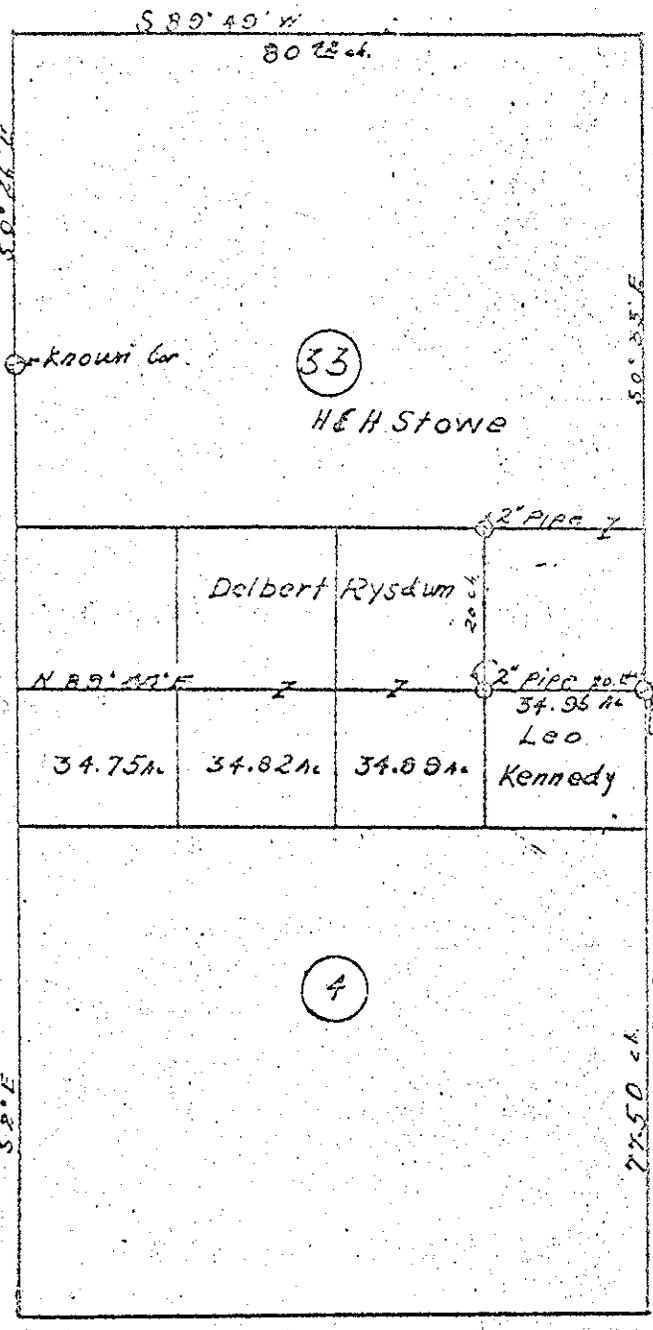

I certify this map is made from notes taken during a field survey in Oct. 1956. Location of respective corrs. are as shown.

REGISTERED
OREGON
LAND SURVEYOR
James G. Voelz
MAY 4, 1953
JAMES G. VOELZ
391



Scale 4" = 1 Mile

