


64

3

3

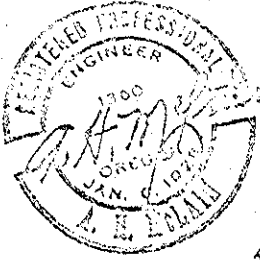


THE NE $\frac{1}{2}$ SECTION 5, TOWNSHIP 2 NORTH
RANGE 40 EAST W.M.

FOR

ALBERT RYSDAM & HOWARD GOOD

SURVEYED OCTOBER 1951.

SCALE 1" = 400'

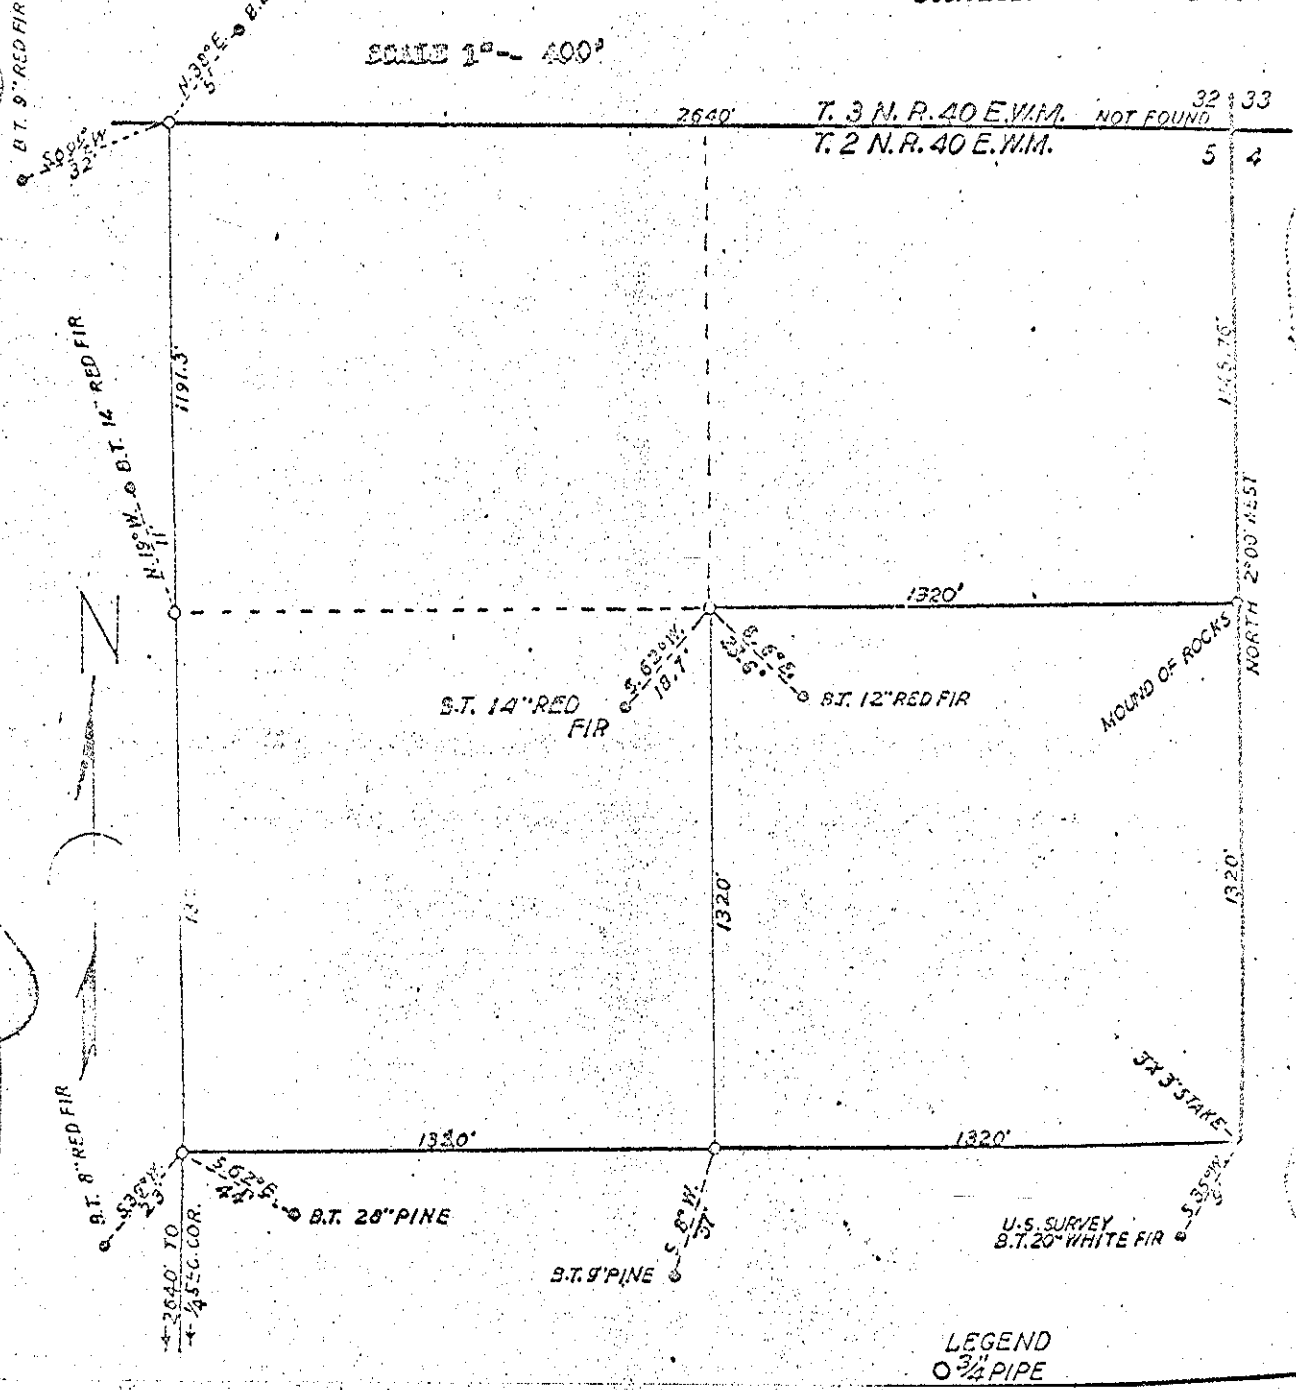

T. 3 N. R. 40 E. W.M.	32	33
T. 2 N. R. 40 E. W.M.	5	4

LEGEND
O 3/4" PIPE