T-1-S R-39-E WM

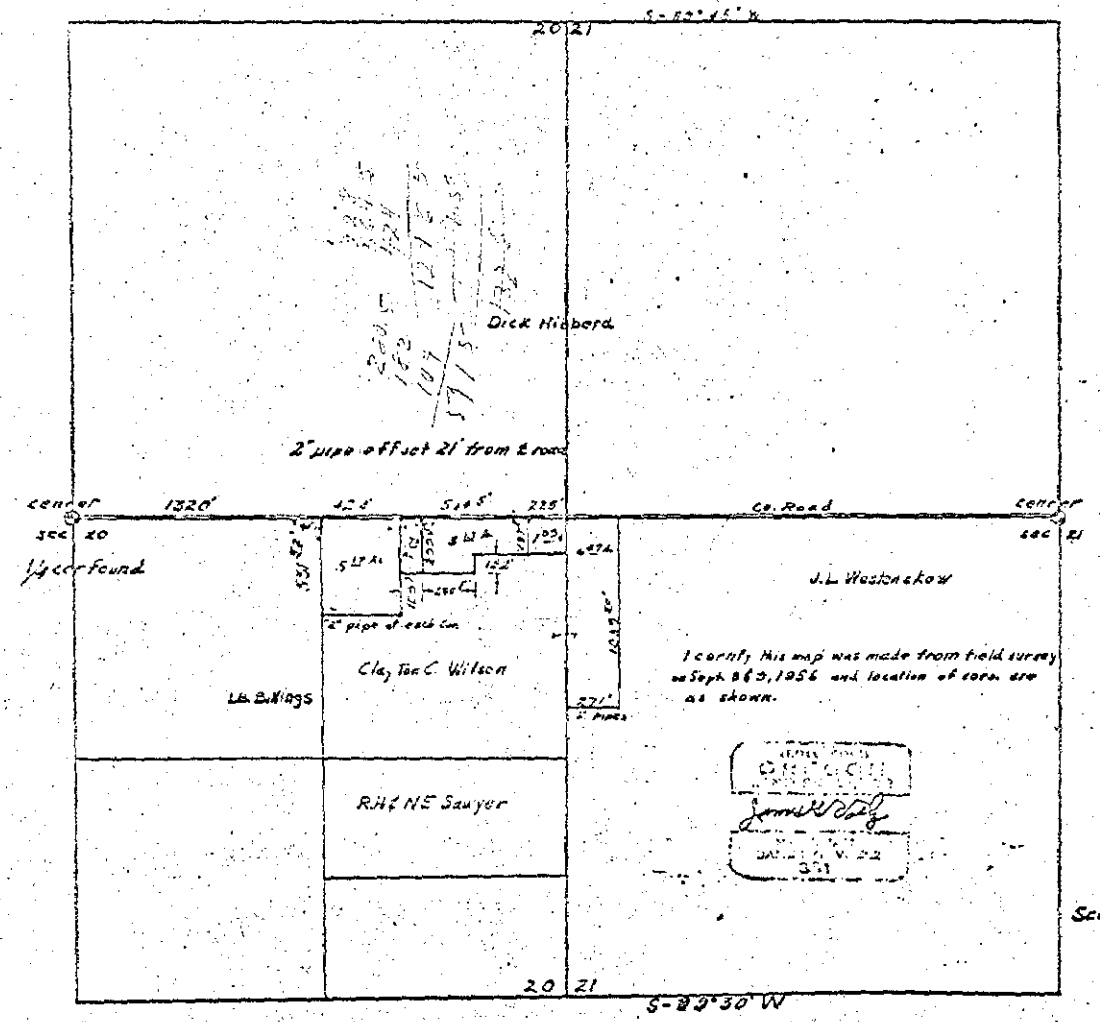
20 21
S-89°45' W
Dick Hibbard
2" pipe offset 21' from t road
center 1320' 42.5' 514.5' 235' Co. Road center
sec 20 sec 21
1/4 cor found
5.17 Ac.
2" pipe at each cor.
Clayton C. Wilson
J.L. Weston ekow
I certify this map was made from field survey on Sept 8 & 9, 1956 and location of corn. are as shown.
L.M. Billings
R.H. & N.E. Sawyer
20 21
S-89°30' W
N
Scale 1"=500'