

11 12 SET CORNER FROM B.T.S. NOV. 1951  
14 13 B.T.S. FOUND. CORNER SET IN  
ACCORDANCE WITH ORIGINAL  
FIELD NOTES.


SURVEY  
OF  
LINE BETWEEN SECTIONS 13 & 14  
TWP. 1 S. - RANGE 40 E. Y.M.  
UNION COUNTY - OREGON  
SCALE 1" = 600' - Sept. 1957

2674.21'  
NORTH

1/4 CORNER FOUND - STONE 24" X 15" X 7"  
MARKED 1/4

BROOKS  
15 ACRES  
1920

2640.0'  
NORTH

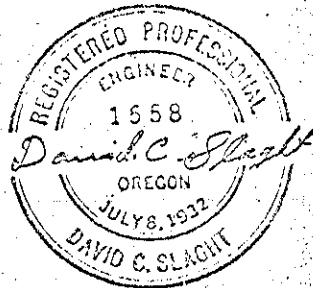

14 13  
23 24

SET 1/4" I.P. 5 FT. LONG  
4 FT. IN GROUND.