

SW 1/4

SE 1/4

REGISTERED
OREGON
 LAND SURVEYOR
James G. Voelz
 MAY 4, 1958
 JAMES G. VOELZ
 381

I certify this survey completed by me in Nov. 1950

P. Cuthbert

25 38

Scale 7 1/2" = 1

13

4 Cor.

23 24
26 25

25

Harricte Ann
Barlow

Gladys Holmes
Geraldine Klesson

Carrie M. Trollinger

30 60 1/2


10.04

House

Concrete
Paved
COUNTRY ROAD

26 83 ch

50 15 ch

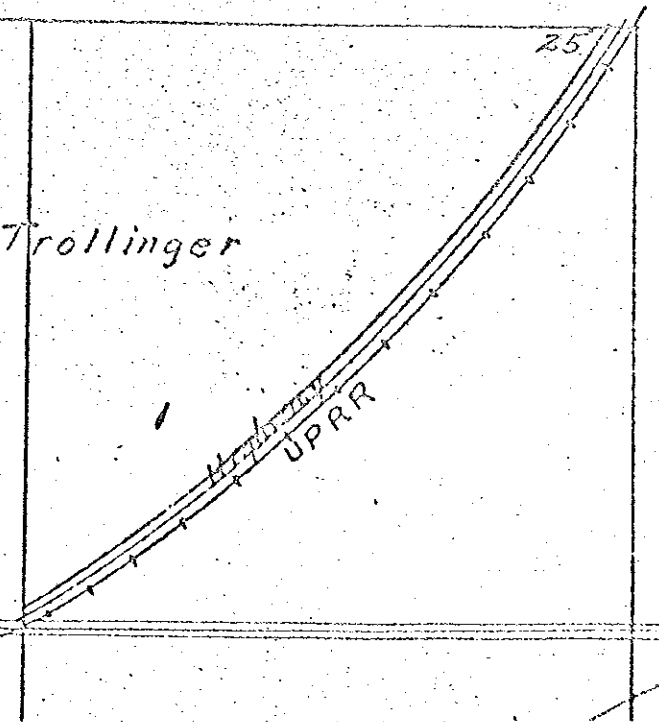

13