SURVEY

OF

TRACT OF LAND IN NW SE SECTION 7, T3S, R3E, W.M.

OWNED BY HUGH & KATHRYN SNIDER

MAY 1949.

SCALE 1" = 100'

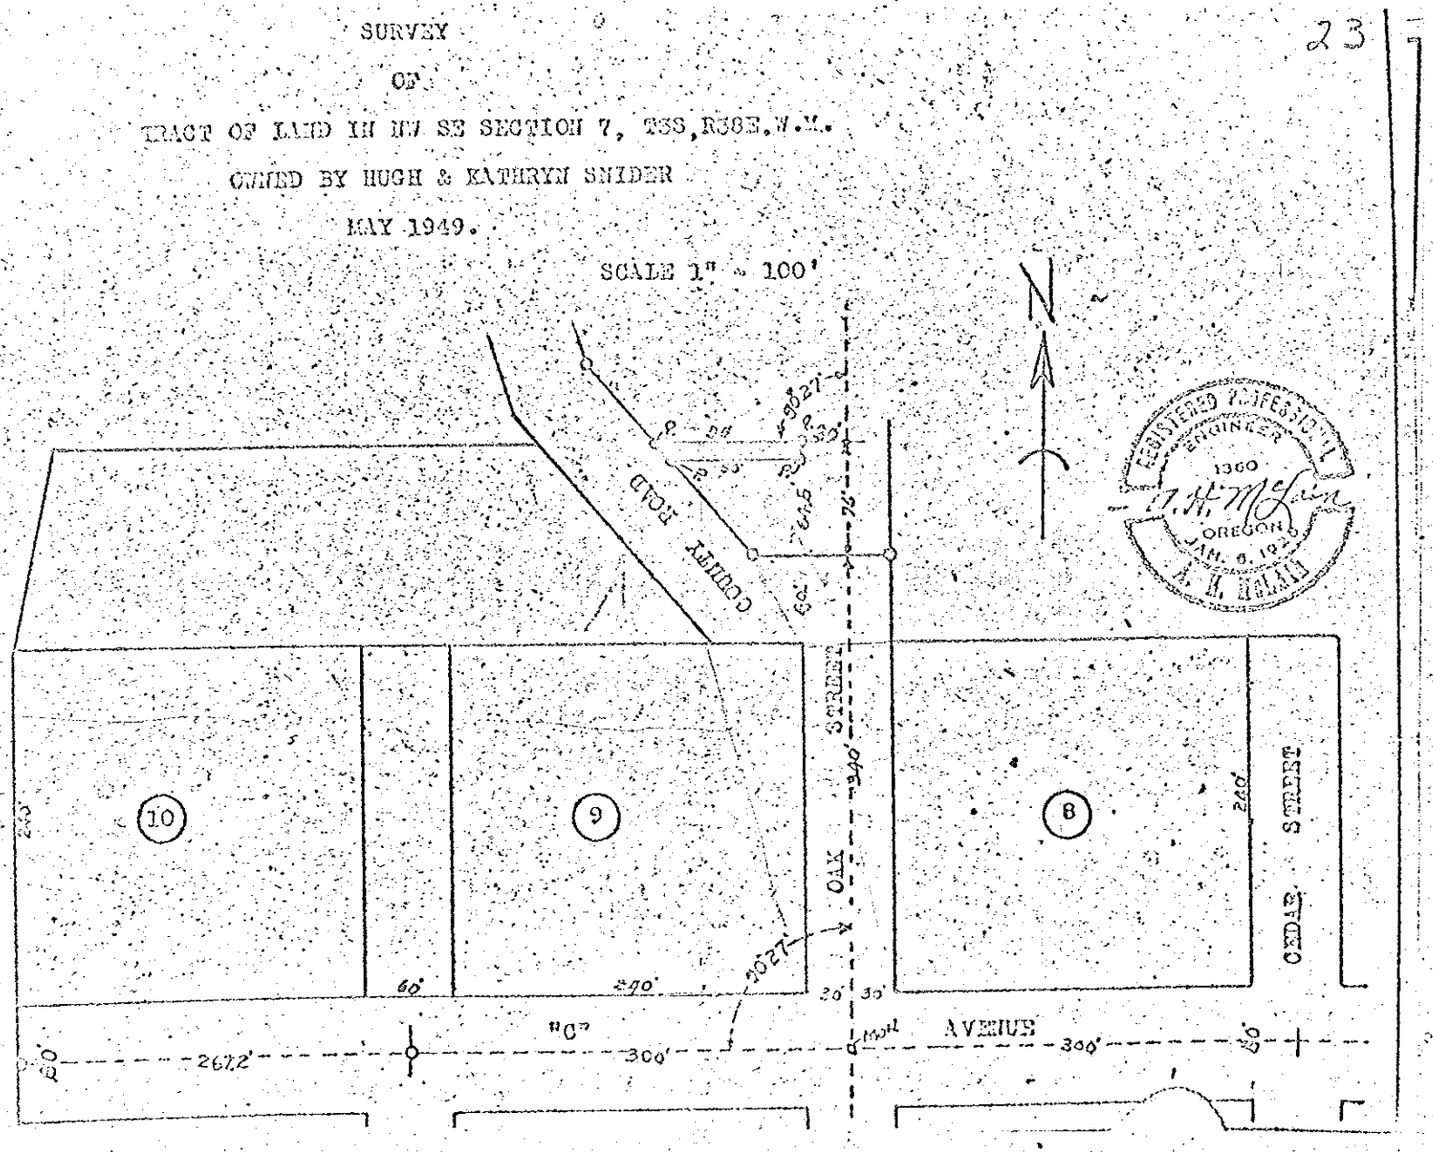

23

23