



24

Sec 8 T35 F

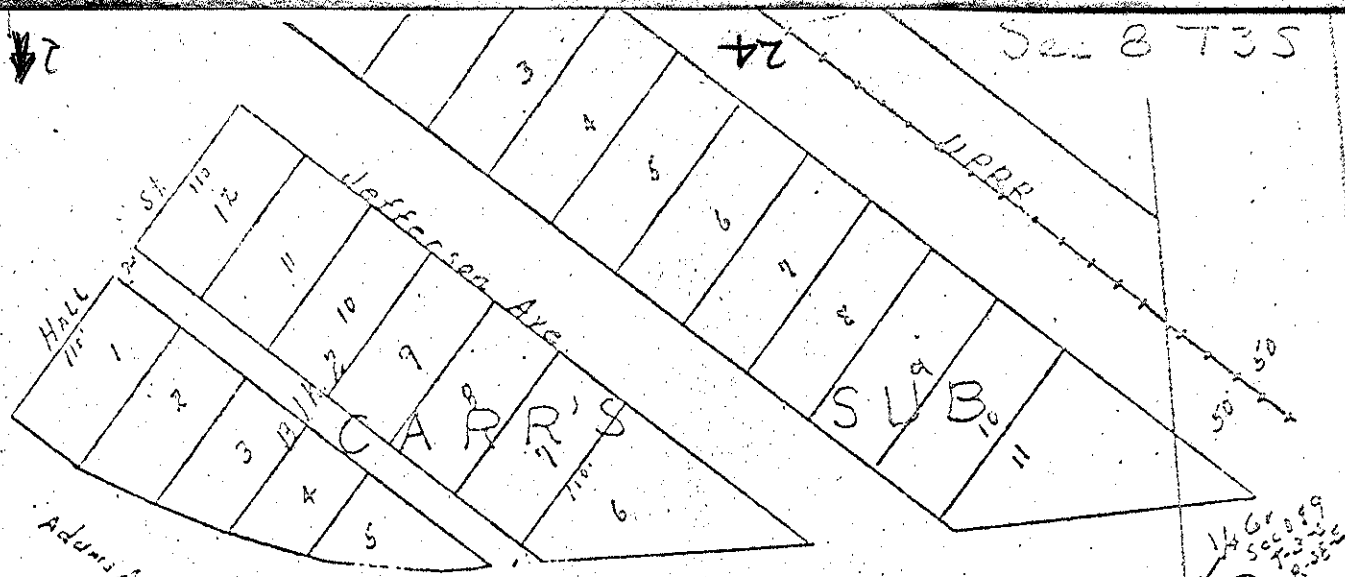

Highway US-30

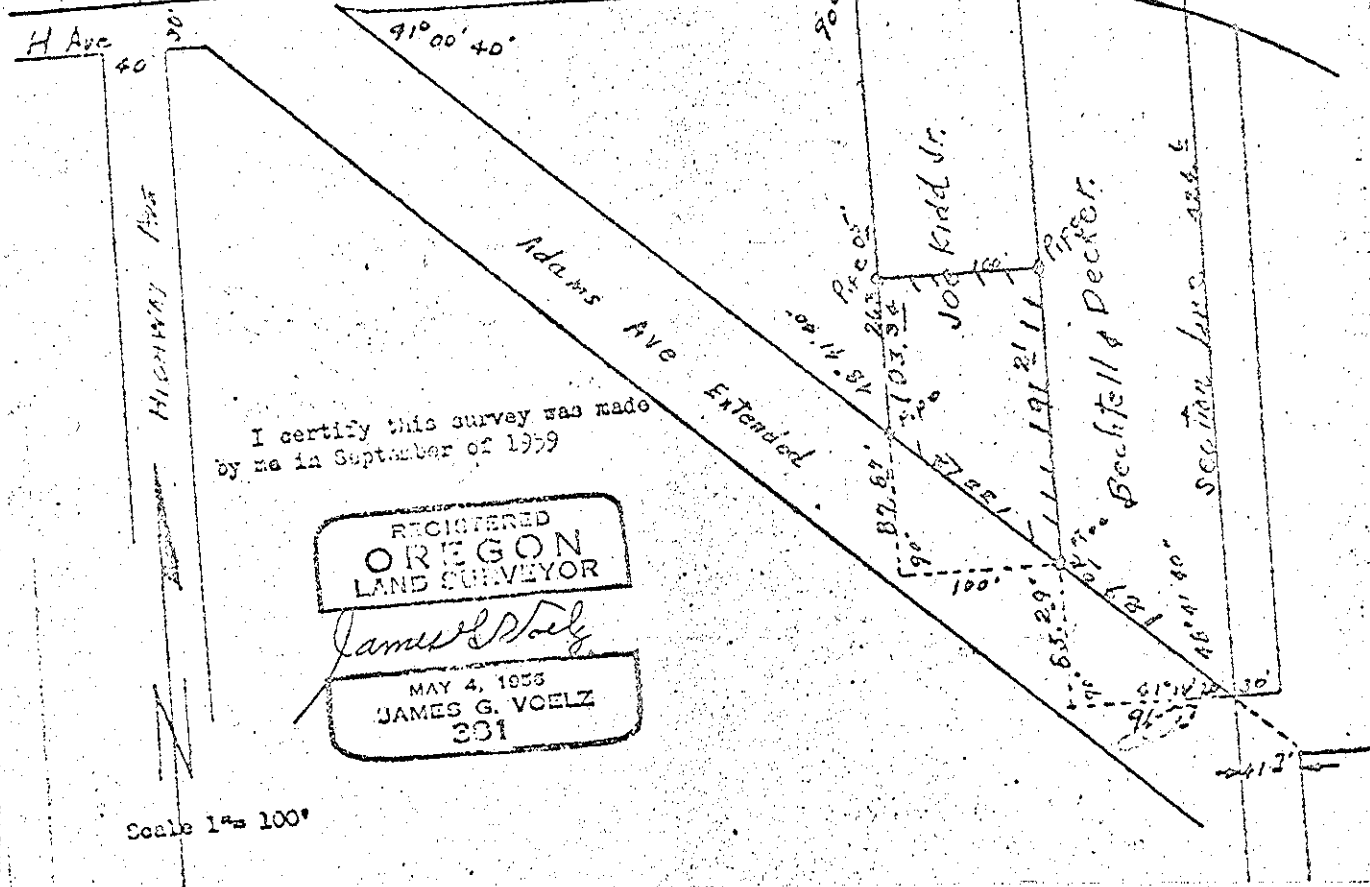

I certify this survey was made by me in September of 1959

REGISTERED  
**OREGON**  
 LAND SURVEYOR  
*James G. Voelz*  
 MAY 4, 1955  
**JAMES G. VOELZ**  
 391

Scale 1" = 100'

24